

Name Oscar Carlson

Service No. 154

Address 21 Colony Road

Location

Kind of Pipe

Size

Size of Main

~~Repair~~ ~~Renewal~~ ~~New Service~~ ✓ Dave Eagle # 2427 W.O.#1452

Location APR 8 1974


Date	Material	Amount	Total	Date	Amount
11-14 73	40' - 6" ACP			11-30-73	200.00
	10' - 4" CI			4-12-74	94.96
					<u>\$ 294.96</u>
11/7/73	Labor	184.84			NON-CHARGE
	10% O.H.	18.48	203.32	11/20/73	Labor
					\$18.77
	4 5" x 6" Nipple w/coupling		19.80		3½ Ton Cold Patch
					28.88
	1 6" x 8" Cast Iron Saddle		11.97		2 hrs. Trucking @ 3.00
					6.00
	1 1¼" Sweep		2.35		1 hr. Roller @ 2.00
					<u>2.00</u>
	1 6" Cap		1.77		\$55.65
	5 hrs. Trucking @ 3.00		15.00		
	5½ hrs. Backhoe @ 6.50		35.75		
	1 hr. Compressor @ 5.00		5.00		
			<u>\$294.96</u>		

DATE _____

TOWN OF LEXINGTON — BOARD OF PUBLIC WORKS

SEWER DIVISION

Sketch of Service Here **21**

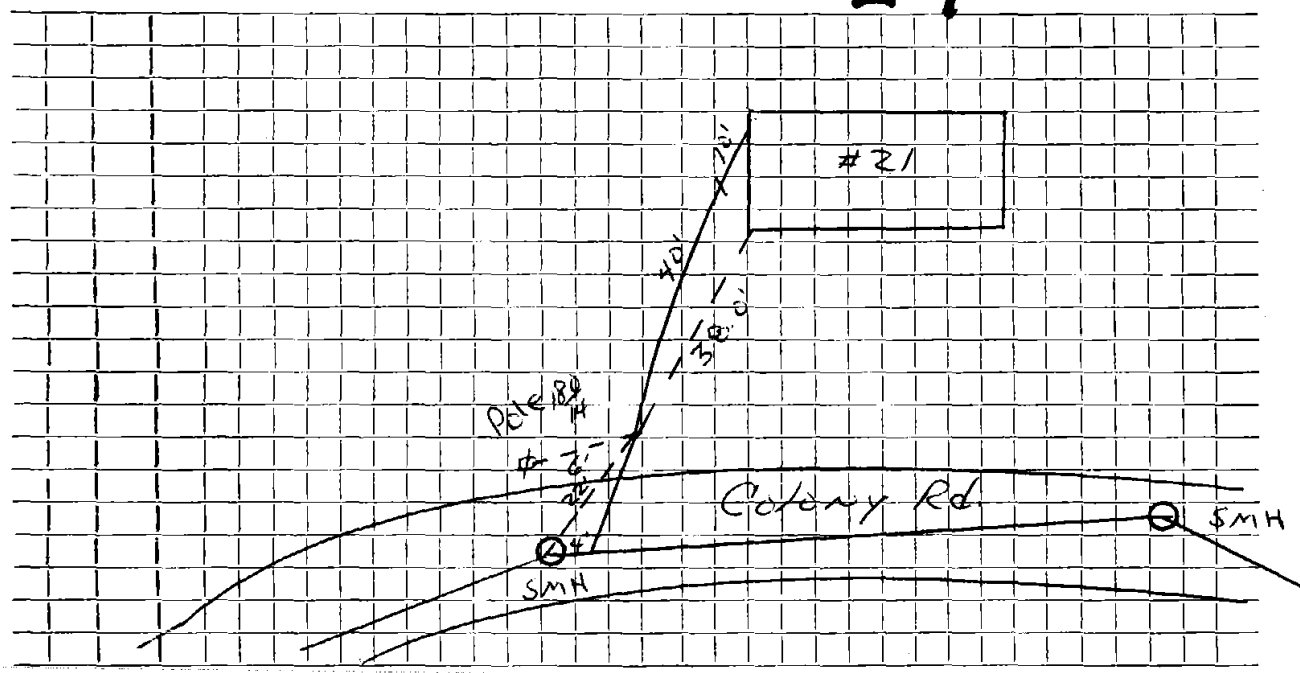

Connection made in Street. Work completed

Remarks:
.....
.....