

Name Mrs Charles Miller

Service No. 45

Address #24 COLONY RD.

Location

Kind of Pipe

Size

Size of Main

~~Repair~~ ~~Renewal~~ - New Service Lexington Sewerage #A217  
100 # 215


Location OCT 25 1965

Date		Material	Amount		Total		Date		Amount
5-11-65		Labor	77	93			5-3-65	Deposit	125 00
		10% O.H.	7	79	85	72	11-8-65	Paid	4 19
	16'	6" Transite pipe @ .82			13	12			129 09
	1	8 X 6 Saddle			5	25			
		6 X 3 Patch			6	00			
	2	Hrs Town Truck @ 3.00			6	00			
	2	Hrs Tractor @ 6.50			13	00			
					129	09			
4/5/66	56'	6" Transite pipe							

DATE \_\_\_\_\_

TOWN OF LEXINGTON — BOARD OF PUBLIC WORKS  
SEWER DIVISION

Sketch of Service Here **24**

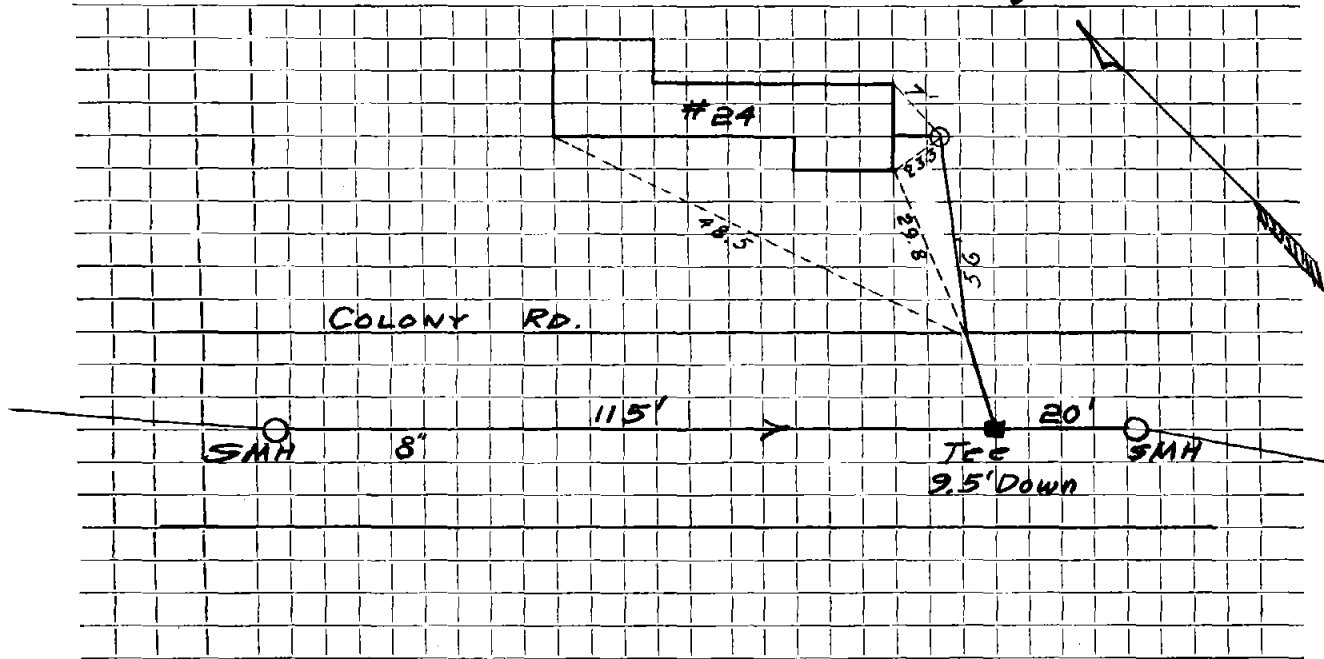

Connection made in ..... Street. Work completed .....

Remarks: .....  
.....  
.....