


DATE 11/18/21

TOWN OF LEXINGTON — BOARD OF PUBLIC WORKS
SEWER DIVISION

Sketch of Service Here

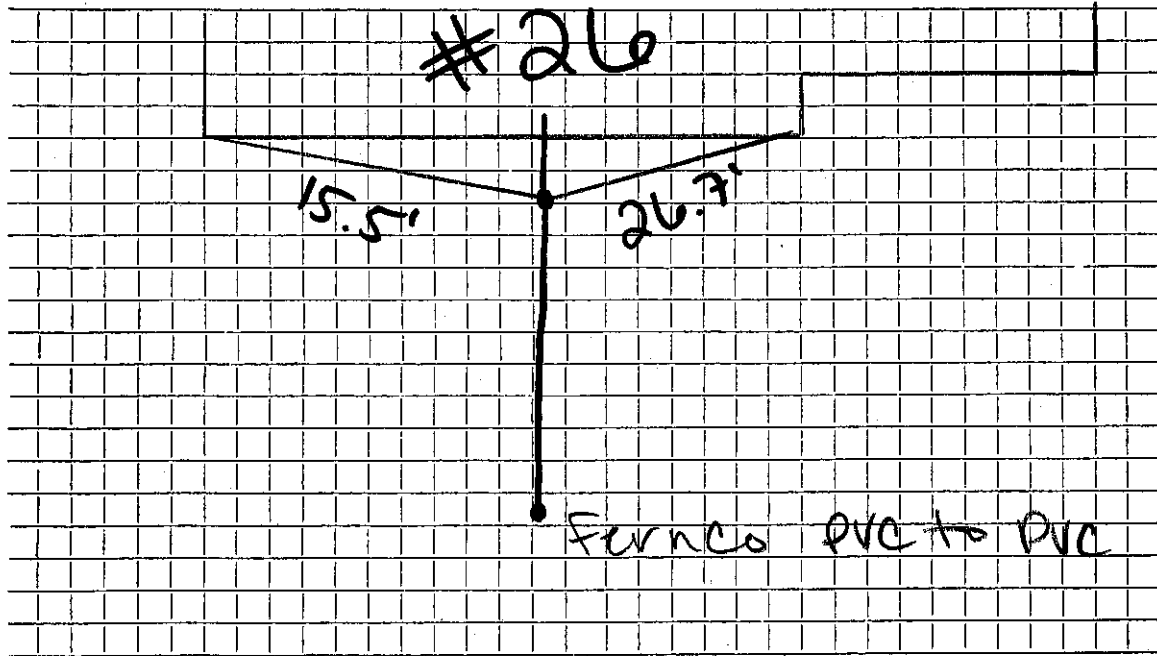

Connection made in ... Colony Rd ... Street. Work completed

Remarks: ... depth Cleanout = 4'
Address changed from 36 Colony Rd to 26 Colony Rd