

Name William Jackman

Service No. 195

Address #27 COLONY RD.

Location

Kind of Pipe

Size

Size of Main

~~Repair~~ ~~Renewal~~ - New Service

100 # 7232

Location


Comm 1-14-63

Date	Material	Amount	Total	Date		Amount
11-30-62	Labor	99.59		11-14-62	Deposit	200.00
	10% O.H.	9.96	109.55	2-18-63	Abate	20.00
46'	6" Transite pipe @82		37.72			185.45
1	90° Transite Elbow		4.09			
1	6X12 Nipple		1.21			
7½	Ton Bank Gravel @85		6.38			
3	Hrs. Town Shovel @6.50		19.50			
2	Hrs. Trucking @3.00		6.00			
12	X 3 Patch		12.00			
	Spring Loam & Seed		20.00			
			216.45			

DATE _____

TOWN OF LEXINGTON — BOARD OF PUBLIC WORKS
SEWER DIVISION

Sketch of Service Here **27**

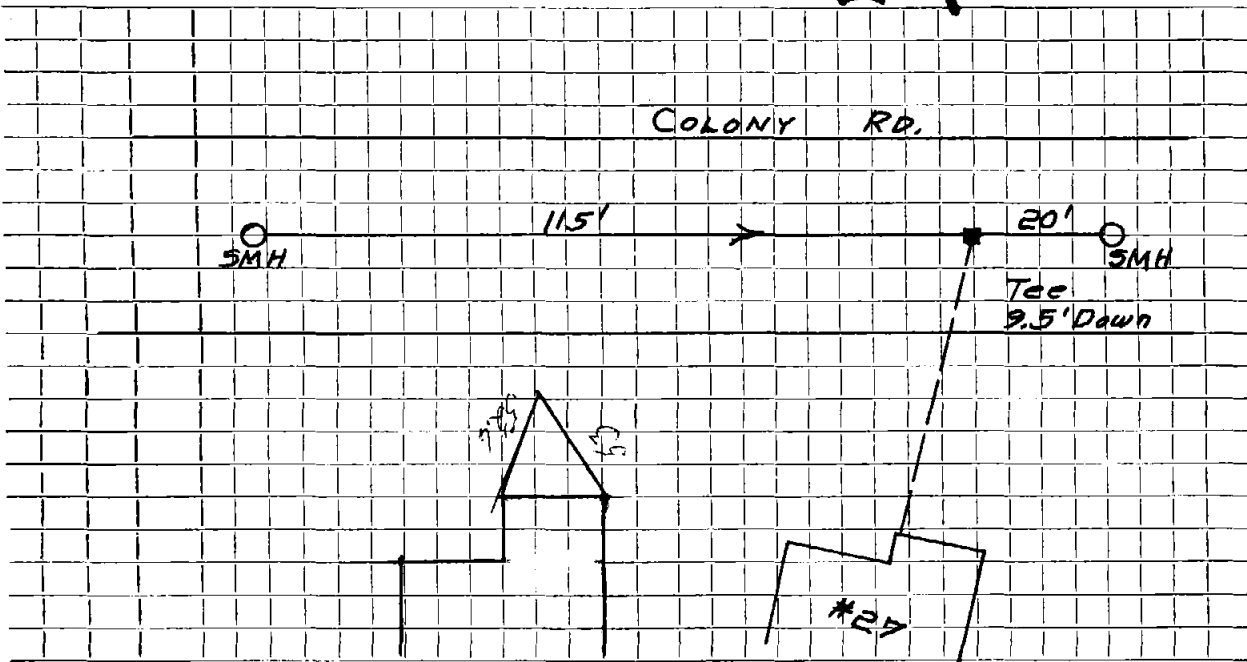

Connection made in Street. Work completed

Remarks:
.....
.....