

Name

Service No.

Address

29 Colony Rd.

Location

Kind of Pipe

Size

Size of Main

Repair—Renewal—New Service

Lexington Sewerage #2100

Location

Date

Material

Amount

Total

Date

Amount

7/20/72

45'

6" Transite pipe

10'

4" Cast Iron pipe

7-10-72

10' 6" Transite

2 6" Couplings


1 6"-11 1/4" Sweep

DATE _____

TOWN OF LEXINGTON — BOARD OF PUBLIC WORKS
SEWER DIVISION

Sketch of Service Here

29

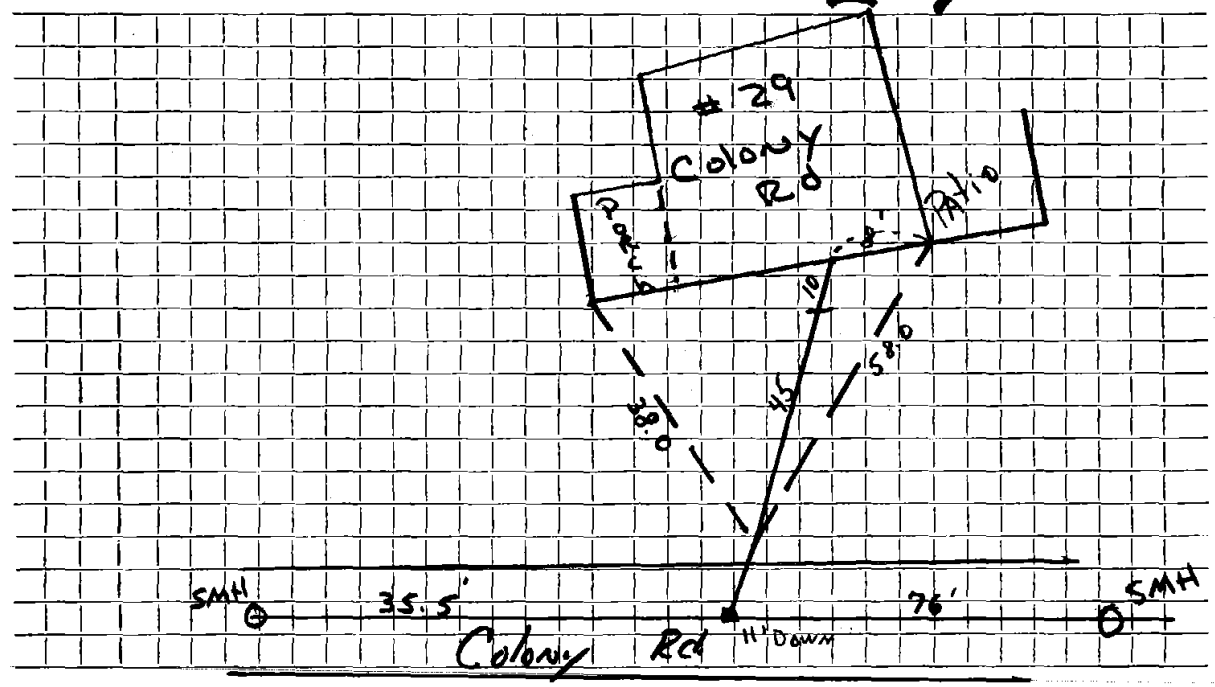

Connection made in Street. Work completed

Remarks:
.....
.....