

Name Daniel Jones

Service No. 170

Address 30 Colony Road

Location

Kind of Pipe

Size

Size of Main

~~Repair/Replacement~~ New Service Lexington Sewerage Permit #A-13 W.O. #1000


Location **MARK 1** = 1966

Date	Material	Amount	Total	Date	Amount
	<i>Outside</i>				
9-27-65	Labor	58 32		9-26-65	125 00
	10% O.H.	5 83	64 15	3-14-66	2 00
	20' 6" Transite pipe @ .82		16 40		127 82
	1 6" Elbow		4 09		
	1 6" Cap		1 93		
	1 6" Collar		75		
	18 x 3 Patch		18 00		
	$\frac{1}{2}$ Yard Loam @ 3.00		1 50		
	1 Hr. Town Truck		3 00		
	2 Hrs. Town Tractor @ 6.50		13 00		
			122 82		
	<i>Inside</i>				
9-29-65	30' 6" Transite pipe				

DATE _____

TOWN OF LEXINGTON — BOARD OF PUBLIC WORKS
SEWER DIVISION

Sketch of Service Here **30**

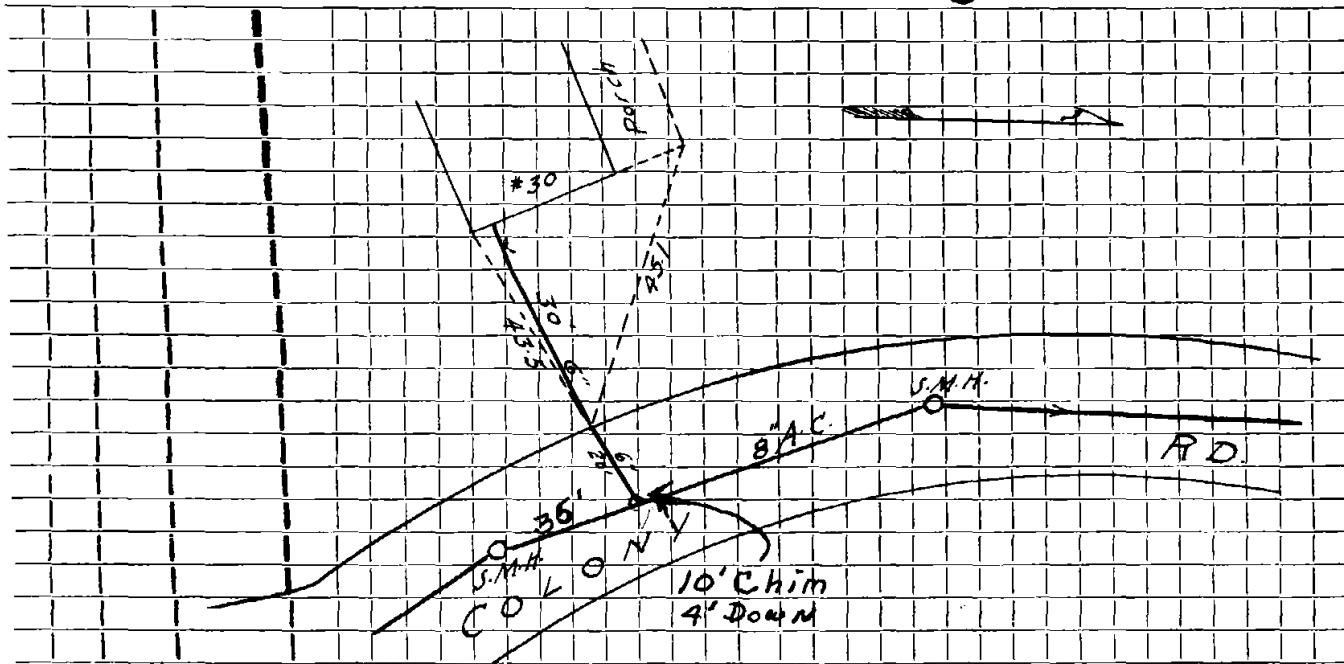

Connection made in Street. Work completed

Remarks:

.....

.....

