

Name Willard P. Grush

Service No. #189

Address #32 COLONY RD.

Location

Kind of Pipe

Size

Size of Main

Repair ~~Renewal~~ - New Service

W O F 2223

Location


Comm 1-14-63

Date	Material	Amount	Total	Date	Amount
11-20-62	Labor 118.40				
11-21-62	" 49.12	167.52			Spring Loam & Seed 20.00
	10% O.H.	16.75	184.27		300.12
	45' 6" Transite pipe @82		36.90	11-13-62	Deposit 2.56 00
	5 Tons 1 1/2" Stone @1.50		7.50		50 12
	6 3/4 Tons Bank Gravel @85		5.74		300 12
	1 11 1/4" Transite Elbow		2.35		
	1 22 1/2" Transite Elbow		2.35		
	1 6" Duplex Adapter		1.62		
	1 11 1/4" Transite Bend		4.09		
	1 6"X12" Nipple		1.21		
	1 90° Transite Elbow		4.09		
	8X3 Patch		8.00		
	2 Hrs. Town Shovel @6.50		13.00		
	2 Hrs. Trucking @3.00		6.00		
	3 Hrs. Pumping @1.00		3.00		

DATE \_\_\_\_\_

TOWN OF LEXINGTON — BOARD OF PUBLIC WORKS  
SEWER DIVISION

Sketch of Service Here **32**

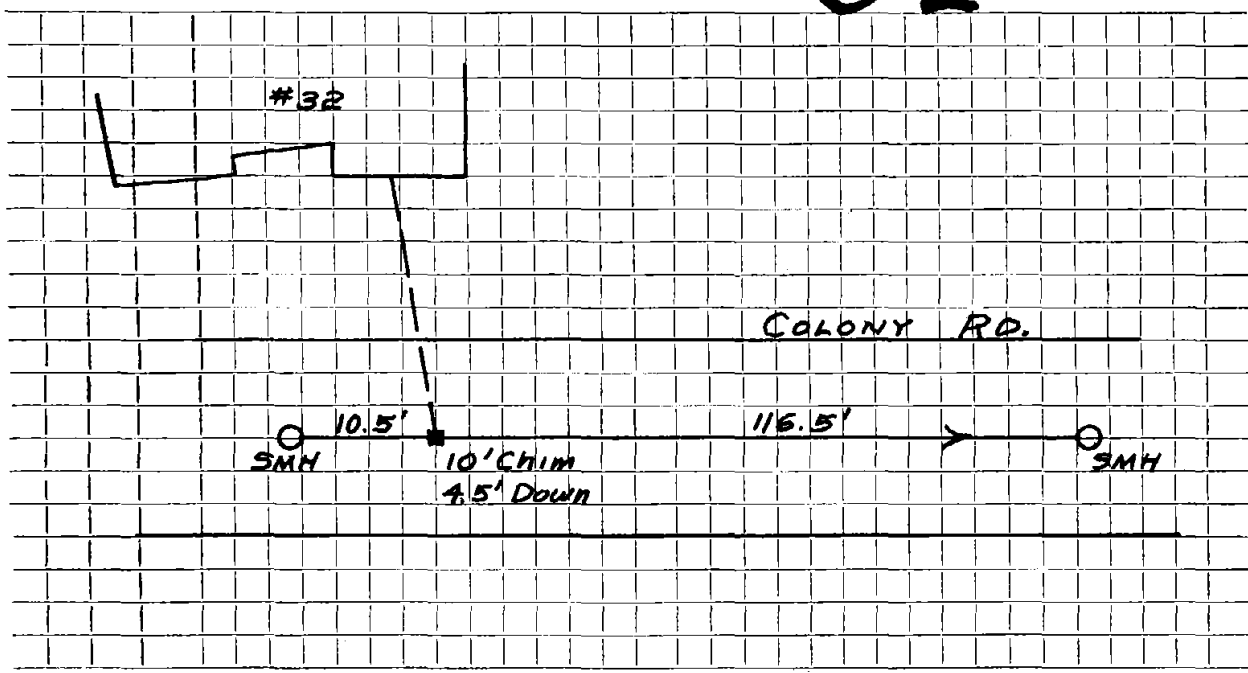

Connection made in ..... Street. Work completed .....

Remarks: .....  
.....  
.....