

Name Pauline C. Wang

Service No. 5

Address #34 COLONY RD.

Location

Kind of Pipe

Size

Size of Main

~~Repair-Removal~~ New Service 1) O# 7796

Location Comm 8-26-63


Date	Material	Amount	Total	Date	Amount
4-22-63	Labor	123.48		2-27-63	350.00
4-23-63	"	29.25	152.73	9-3-63	55.57
	10% O.H.	15.27	168.00		405.57
	110' 6" Transite pipe @.88		96.80		
	1 22 <sup>1</sup> / <sub>2</sub> ° Transite Bend		4.09		
	1 11 <sup>1</sup> / <sub>4</sub> ° Transite Bend		4.09		
	1 90° Transite Elbow		4.09		
	20 x 3 Patch		20.00		
	24 yds. Loam @3.00		72.00		
	3 hrs. Town Truck @3.00		9.00		
	3 hrs. Town Shovel @6.50		19.50		
	2 hrs. Loader @4.00		8.00		
			405.57		

*Bill sent 55.57*

DATE \_\_\_\_\_

**TOWN OF LEXINGTON — BOARD OF PUBLIC WORKS**  
**SEWER DIVISION**

Sketch of Service Here **34**

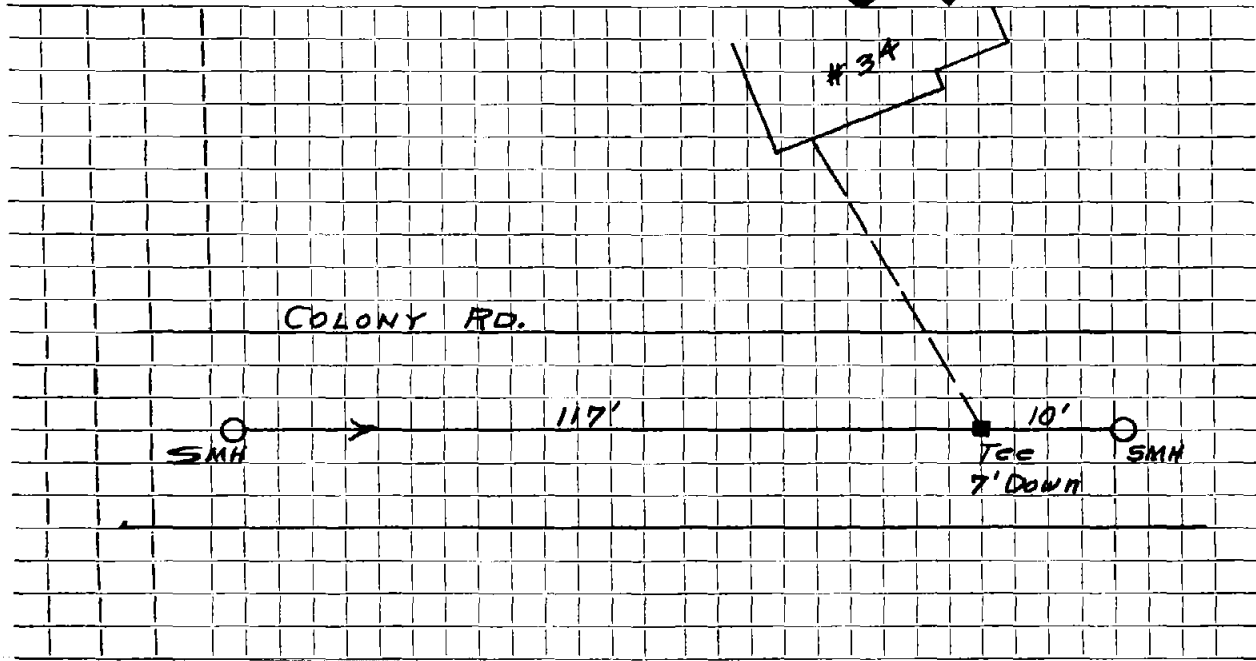

Connection made in ..... Street. Work completed .....

Remarks: .....  
.....  
.....