

Name James. J. McDevitt

Service No. 40

Address # 36 COLONY RD.

Location

Kind of Pipe

Size

Size of Main

~~Repair Renewal~~ New Service WO # 2708


Location Comm 8-26-63

Date	Material	Amount	Total	Date		Amount
5-28-63	Labor	93.69		5-2-63	Deposit	250.00
	10% O.H.	9.37	103.06	8-26-63	Refund	13.91
	78' 6" Transite pipe @.88		68.64			236.29
	1 22 <sup>1</sup> / <sub>2</sub> " Transite bend		4.09	10-7-63	Abate	8.80
	20 x 3 Patch		20.00			227.49
	5 yds. Loam @3.00		15.00			
	3 hrs. Town Shovel @6.50		19.50			
	2 hrs. Trucking @3.00		6.00			
			236.29			

DATE \_\_\_\_\_

**TOWN OF LEXINGTON — BOARD OF PUBLIC WORKS**  
**SEWER DIVISION**

Sketch of Service Here **36**

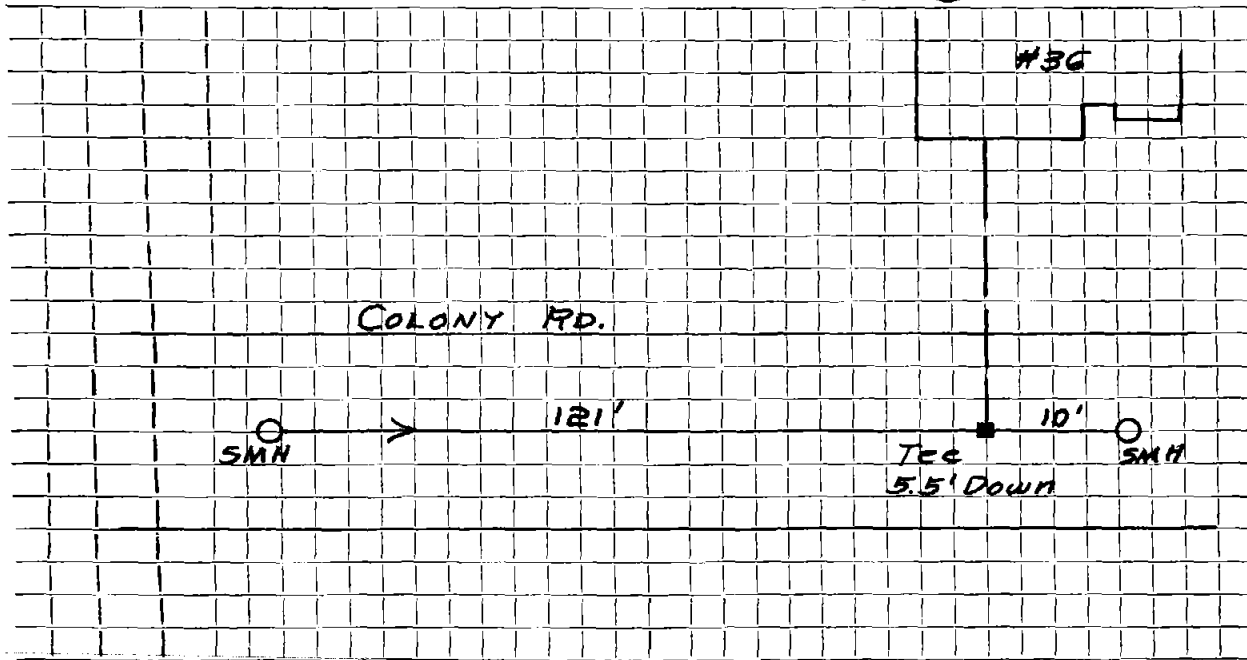

Connection made in ..... Street. Work completed .....

Remarks: .....  
.....  
.....