

Name Mrs. James J. Burton Sr.

Service No. 62

Address # 38 COLONY RD.

Location

Kind of Pipe

Size

Size of Main

~~Repair~~ Renewal - New Service

WO # 8067

Location


Common 10-28-63

Date	Material	Amount	Total	Date	Amount
6-21-63	Labor	79.82		6-6-63	Deposit 300.00
6-24-63	"	18.36		10-28-63	Refund 36.92
6-28-63	"	18.36	116.54		263.08
	10% O.H.	11.65	128.19		
	90' 6" Transite pipe @.82		73.80		
	1 90° Transite Elbow		4.09		
	4 hrs. Town Shovel @6.50		26.00		
	4 hrs. Trucking @3.00		12.00		
	10 x 3 Patch		10.00		
	3 yds. Loam @3.00		9.00		
			<u>263.08</u>		

DATE _____

TOWN OF LEXINGTON — BOARD OF PUBLIC WORKS
SEWER DIVISION

Sketch of Service Here **38**

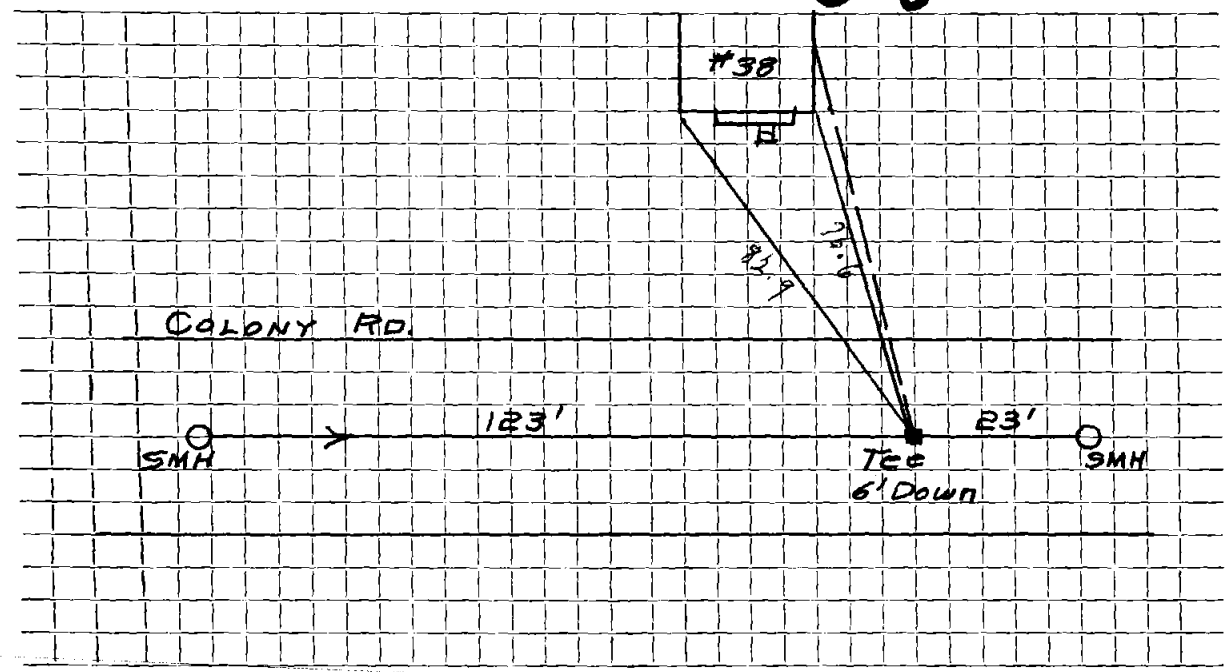

Connection made in Street. Work completed

Remarks:
.....
.....