

Name Richard Runyan

Service No. 152

Address 39 Colony Road

Location

Kind of Pipe

Size

Size of Main

~~Repair Renewal~~ New Service W.O. #7615

Location Comm 12-10-62


Date	Material	Amount	Total	Date		Amount
10-9-62	Labor	99.58		9-7-62	Deposit	210.00
	10% O.H.	9.96	109.54	12-10-62	Refund	6.52
51	6" Transite Pipe @82		41.82			19.37
2	11 1/2" Transite Bend @4.09		8.18			
1	90° Transite Elbow		4.09			
1	22 1/2" Transite Bend		2.35			
3	Hrs. Town Shovel @6.50		19.50			
2	Hrs. Trucking @3.00		6.00			
2	Hrs. Pumping @1.00		2.00			
			<u>193.48</u>			

DATE _____

TOWN OF LEXINGTON — BOARD OF PUBLIC WORKS
SEWER DIVISION

Sketch of Service Here

39

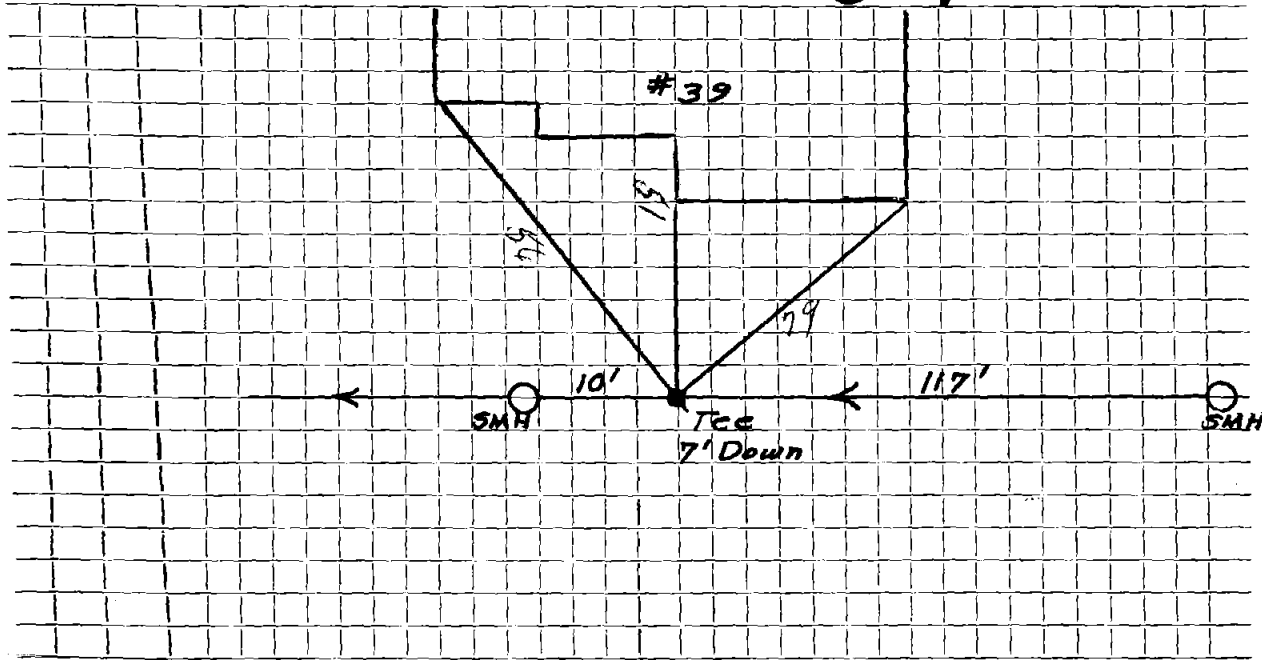

Connection made in Street. Work completed

Remarks:
.....
.....