

Name Paul R. Sugarman

Service No. 138

Address 5 Colony Road

Location

Kind of Pipe

Size

Size of Main

~~Repair Renewal~~ New Service W. O. # 95

Location FEB 12 1973


Date		Material	Amount		Total		Date		Amount	
9/28/72		Labor	80	36			9/21/72	Deposit Paid	180	00
10/2/		"	23	24		2/20/73	12		79	
	10%	O.H.	10	36	113	96			192	79
	20'	6" Transite .90			18	00				
	1	6" <del>ENX</del> Elbow			5	95				
	1	6" Cap			2	38				
	½	Ton cold patch 8.00			4	00				
	1½	Ton hot top 8.00			12	00				
	4	Hrs. Trucking 3.00			12	00				
	½	Hr. Compressor 5.00			2	50				
	1	Hr. Loader			5	00				
		Roller			2	00				
		Trailer			2	00				
					192	79				

DATE \_\_\_\_\_

**TOWN OF LEXINGTON — BOARD OF PUBLIC WORKS**  
**SEWER DIVISION**

Sketch of Service Here

5

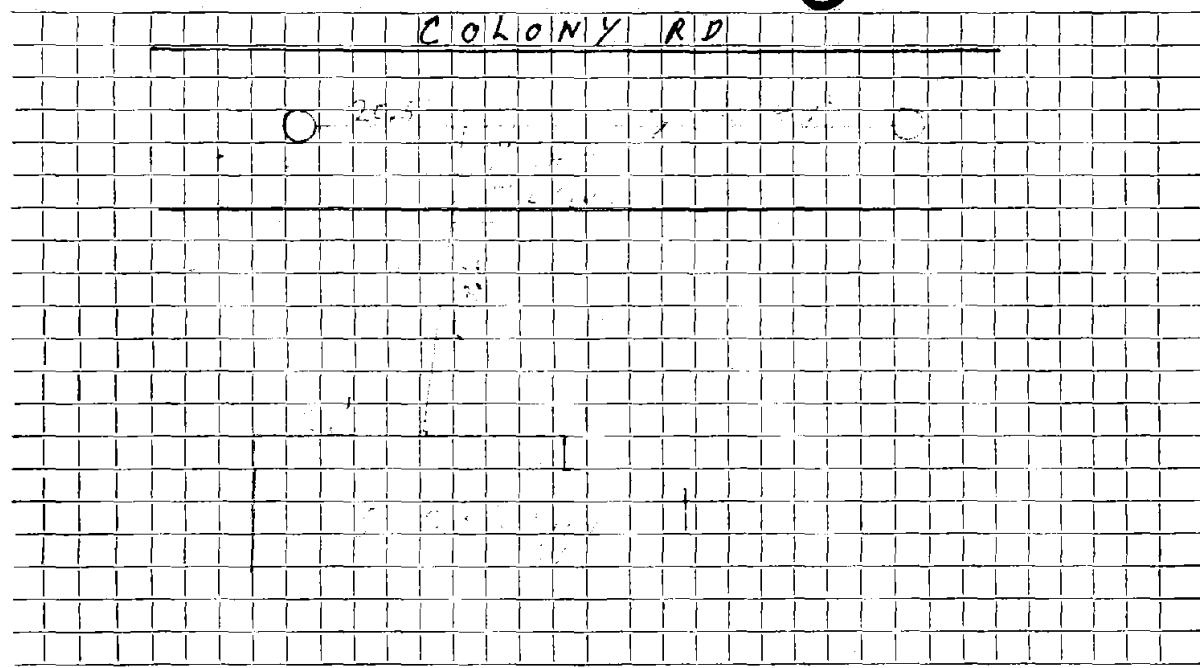

Connection made in ..... Street. Work completed .....

Remarks: .....  
.....  
.....