




DATE \_\_\_\_\_

# TOWN OF LEXINGTON — BOARD OF PUBLIC WORKS SEWER DIVISION

Sketch of Service Here

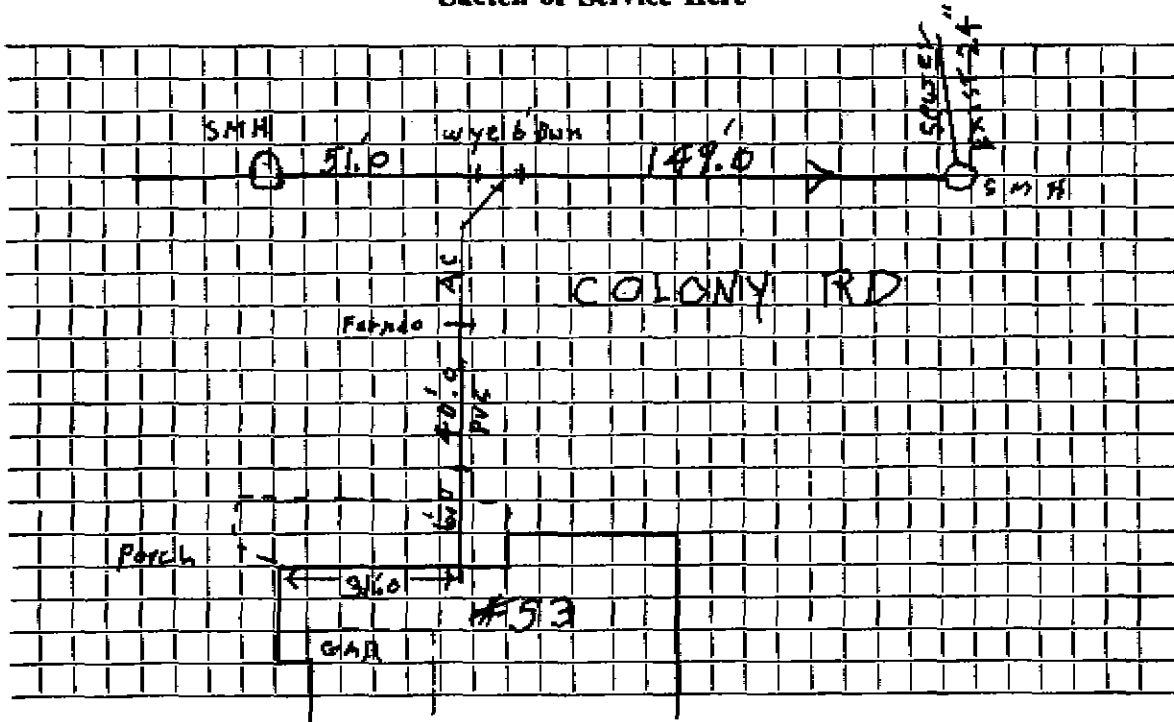

*WISYARIC 4/24*

Connection made in ..... Street. Work completed .....

Remarks: .....  
.....  
.....