

Name George Estey

Service No. 86

Address #54 COLONY RD.

Location

Kind of Pipe

Size

Size of Main

~~Repair/Repair~~ New Service

W.O.# 8066

Location *Comm. - 28-63*


Date	Material	Amount	Total	Date		Amount
7-18-63	Labor	86.74		7-12-63	Deposit	250.00
	10% O.H.	8.67	95.41	10-28-63	Refund	64.70
	49' 6" Transite pipe @ .82		40.18			185.30
	1 90° Transite Elbow		4.09			
	1 6" Duplex Adapter		1.62			
	2 hrs. Town Shovel @ 6.50		13.00			
	2 hrs. Trucking @ 3.00		6.00			
	16 x 3 Patch		16.00			
	3 yds. Loam @ 3.00		9.00			
			185.30			

DATE \_\_\_\_\_

TOWN OF LEXINGTON — BOARD OF PUBLIC WORKS  
SEWER DIVISION

Sketch of Service Here

54

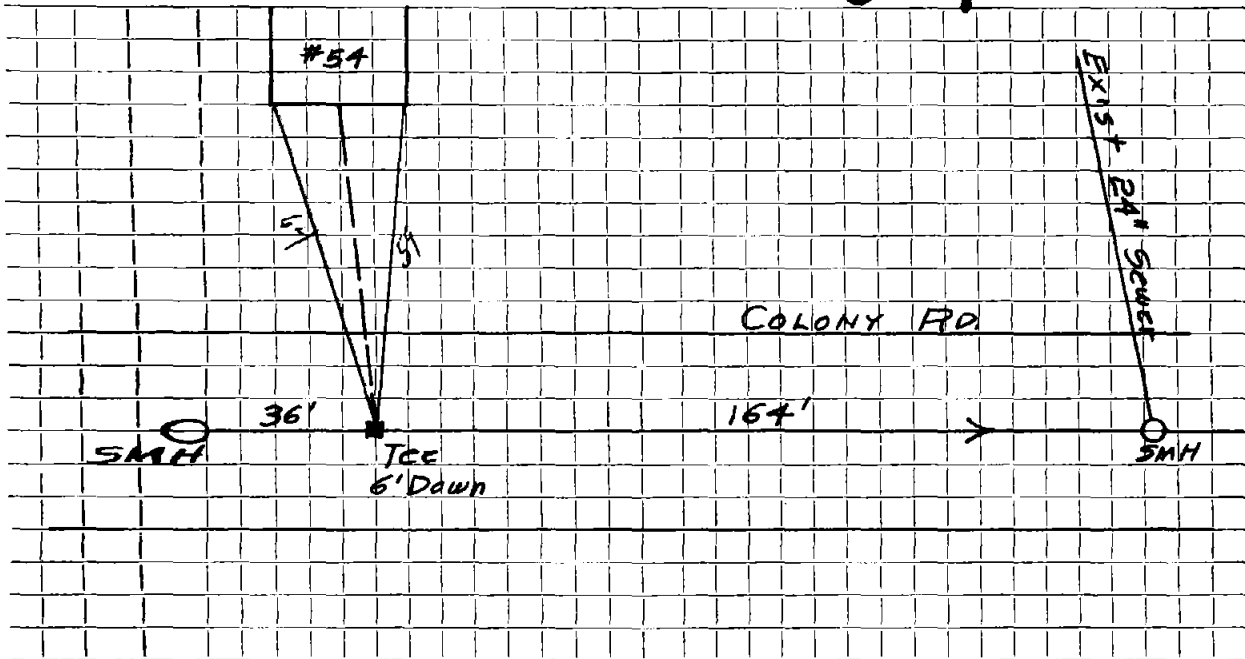

Connection made in ..... Street. Work completed .....

Remarks: .....  
.....  
.....