

Name

Service No. 1793

Address 57 Colony RD

Location

Kind of Pipe PVC

Size 6

Size of Main

Repair—Renewal—New Service J McLaughlin


Location

Date	Material	Amount	Total	Date	Amount
6/17/05	6' 4" PVC				
	51.0 6" PVC				
	1 4x6 Ferrulo				
	1 6" A.C. x PVC Ferrulo				
9/27/57	EXIST				
	50' - A.C.				
	1 8" x 6" Wye				
	1 22° bend				

DATE 6/14/05

TOWN OF LEXINGTON — BOARD OF PUBLIC WORKS  
SEWER DIVISION

Sketch of Service Here

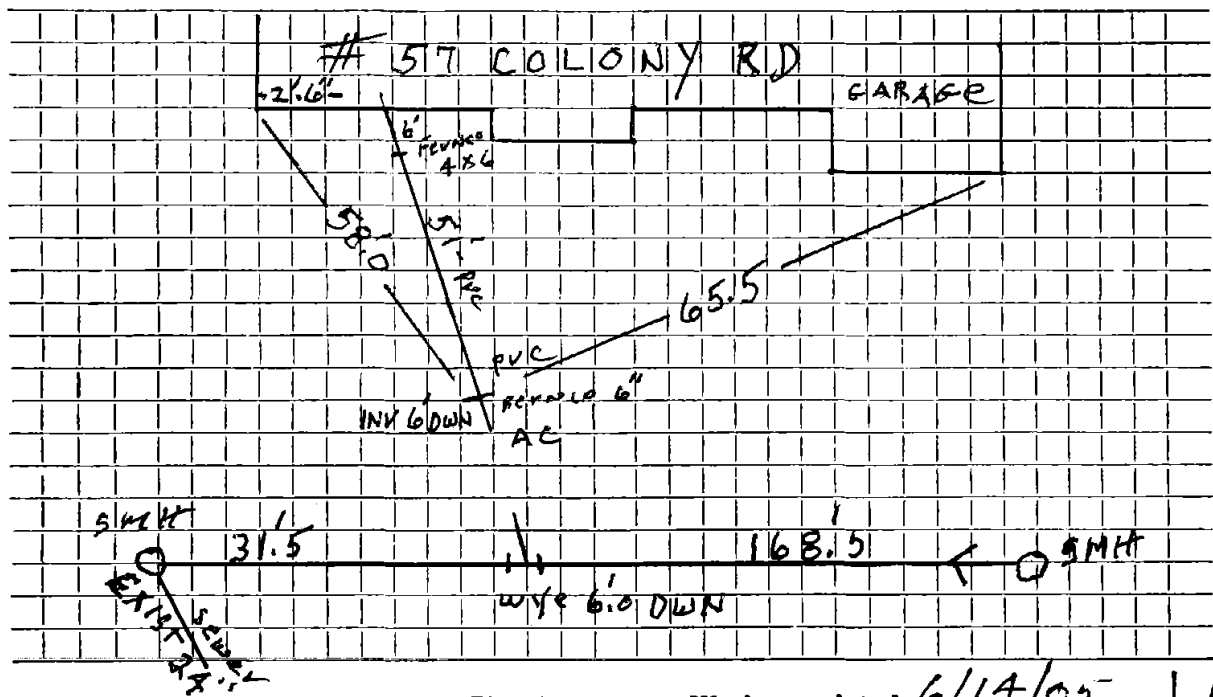

Connection made in ..... Street. Work completed 6/14/05 J. Malan & Co.

Remarks: .....  
.....  
.....