

Name Mrs. James W. Smith

Service No. 191

Address 6 Colony Road

Location

Kind of Pipe Lexington Sewerage Co.-Permit 161

Size

Size of Main

Repair-Renewal-New Service W.O. #9374

Location FEB 15 1965


Date	Material	Amount	Total	Date	Amount
11-30-64	Labor	77 52		11-18-64	150 00
	10% O.H.	7 75	85 27	2-25-65	80 88
23'	6" Transite Pipe @.82		18 86		2.30 88
1	90° Elbow		4 09		
	26 x 19 Patch		86 66		
4	Hrs. Town Shovel @ 6.50		26 00		
2	Hrs. Town Truck @ 3.00		6 00		
1	Hr. Loader		4 00		
			230 88		
12-16-64	44' 6" Transite Pipe				84 88

DATE _____

TOWN OF LEXINGTON — BOARD OF PUBLIC WORKS
SEWER DIVISION

Sketch of Service Here

6

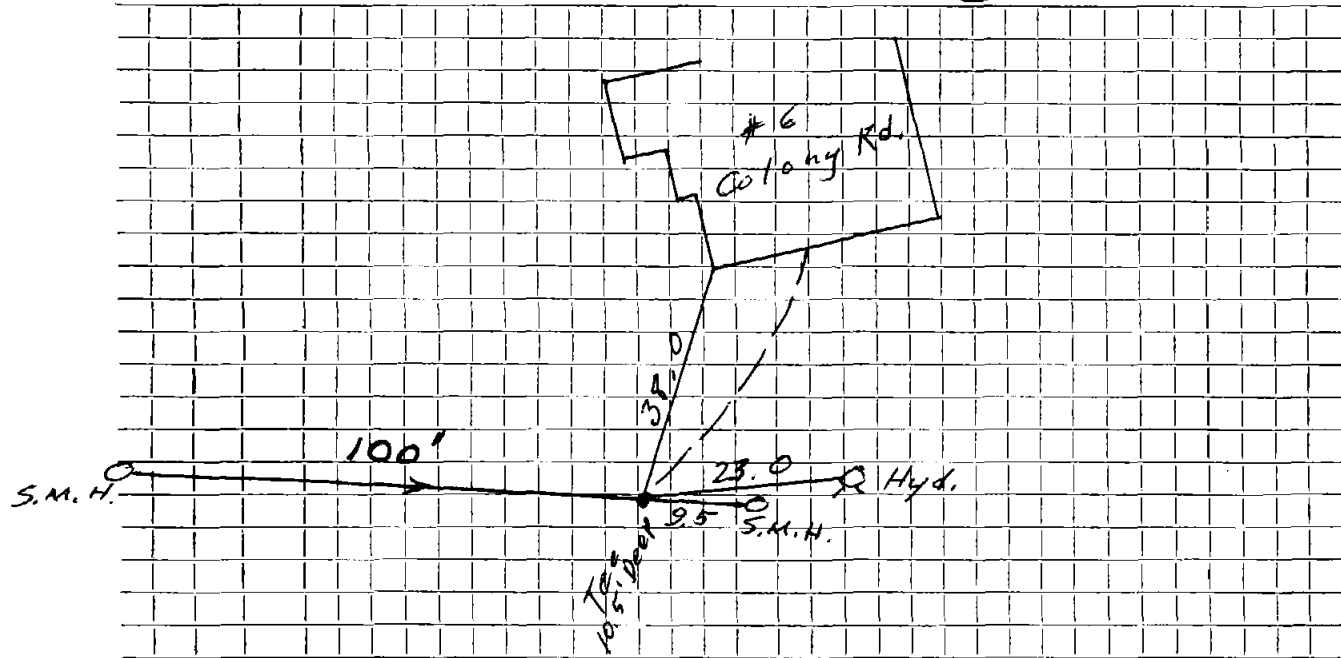

Connection made in Street. Work completed

Remarks:

.....

.....