


DATE _____

TOWN OF LEXINGTON — BOARD OF PUBLIC WORKS

SEWER DIVISION

Sketch of Service Here **62**

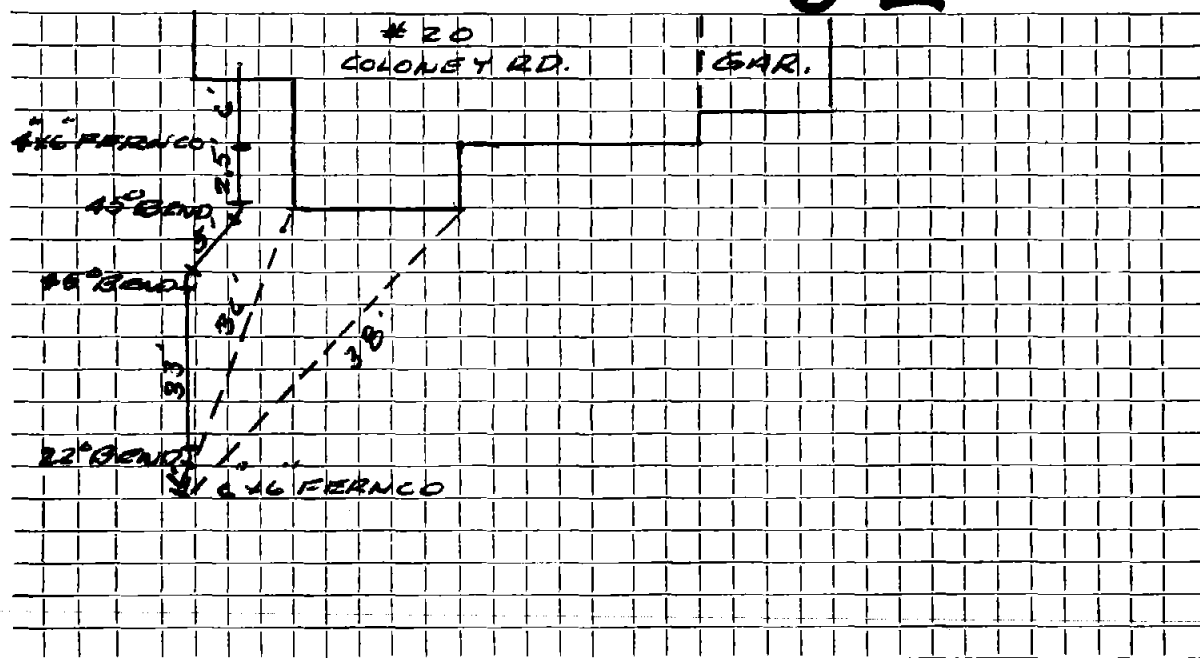

Connection made in COLONEY RD. Street. Work completed

Remarks: Original Service 11-7-56