

Name Sterling Building Corp.

Service No. 31

Address 65 Colony Road

Location

Comm. 9/3/57

Kind of Pipe

Size

Size of Main

~~Repair~~ ~~Renewal~~ — New Service

Location

Date	Material	Amount	Total	Date		Amount
5/16/57	Labor	53 45		4-1-57	Deposit	\$ 200 00
	10% overhead	5 35	58 80	9-3-57	Refund	42 59
	62' - 6" Transite Pipe @ .7020		43 52			\$ 157 41
	1 - 6" Elbow		5 59			
	3 hrs. Town Shovel @ 6.50		19 50			
	1 hr. Trucking		3 00			
	1 hr. Rodgers Trailer		3 00			
	24x3 Patch		24 00			
			157 41			
	Labor					

**TOWN OF LEXINGTON—DEPT. OF PUBLIC WORKS**  
**SEWER DIVISION**

DATE.....

NO. ....


The undersigned applies for the construction of a particular sewer connecting No.....  
Street and hereby agrees to comply with the Rules and Regulations governing the construction and use of Particular  
Sewers, as now or at any future time established by the Board of Selectmen.

Am't of estimate \$.....

Am't Paid \$.....

..... Owner

**Sketch of Service Here**

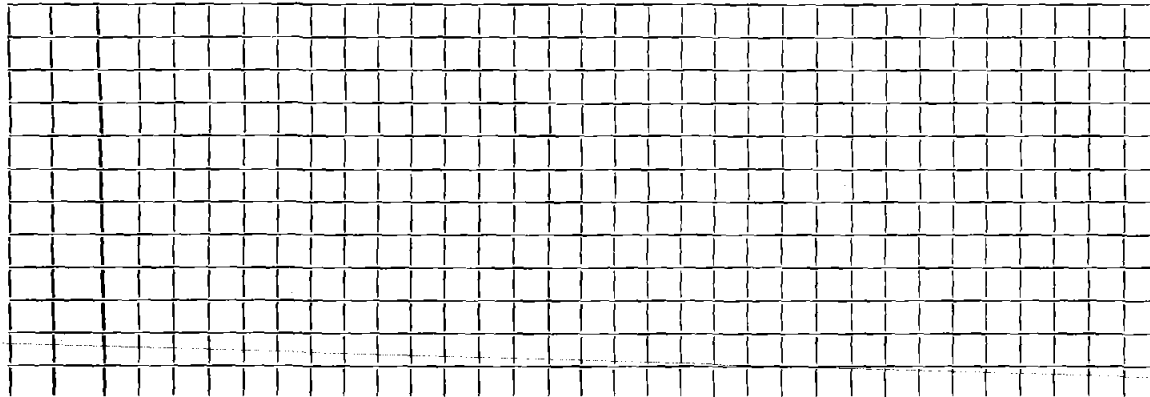

Connection made in ..... Street.

Work completed.....19...

Remarks: