

Name Russell Skinner

Service No. 97

Address #9 Colony Rd.

Location

Kind of Pipe

Size

Size of Main

~~Repair/ Renewal~~ - New Service

WO # 8098

Location


Comm 10-28-63

Date	Material	Amount	Total	Date		Amount
9-10-63	Labor	76.36		8-8-63	Deposit	350.00
	10% O.H.	7.64	84.00	10-28-63	Refund	166.00
	56' 6" Transite pipe @.82		45.92			184.00
	1 90° Transite Elbow		4.08			
	6 x 3 Patch		6.00			
	4 yds. Loam @3.00		12.00			
	4 hrs. Town Shovel @6.50		26.00			
	2 hrs. Trucking @3.00		6.00			
			184.00			

DATE _____

TOWN OF LEXINGTON — BOARD OF PUBLIC WORKS
SEWER DIVISION

Sketch of Service Here **9**

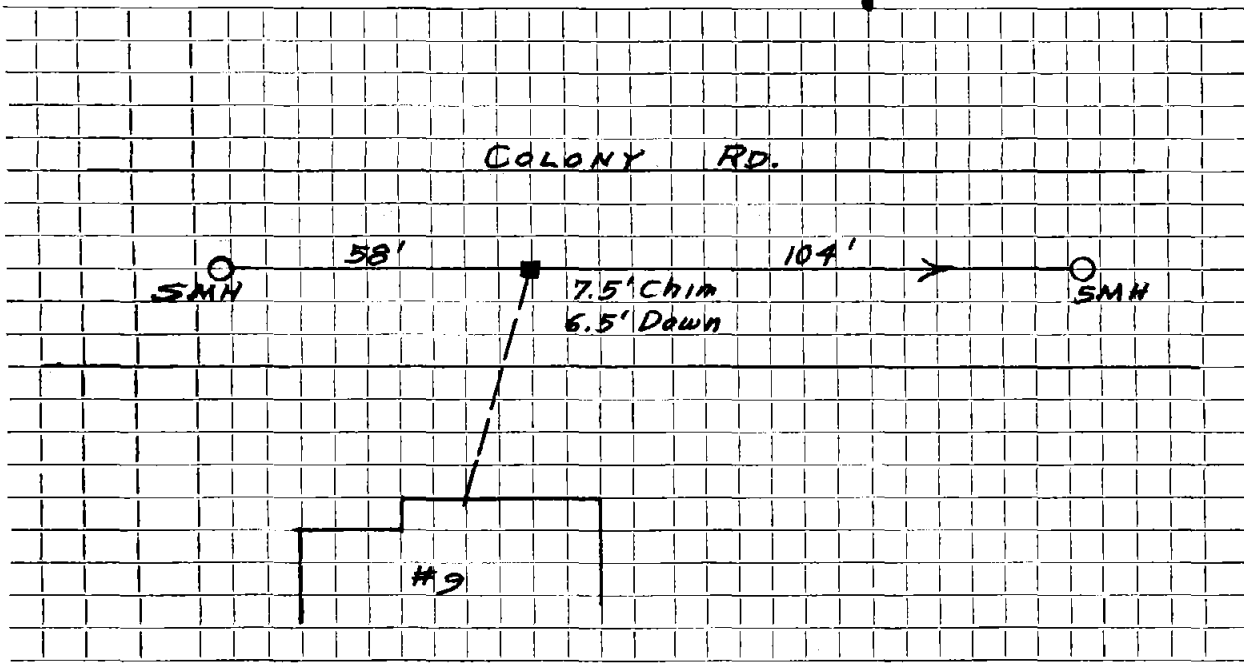

Connection made in Street. Work completed

Remarks:
.....
.....