


DATE 11/13/19

TOWN OF LEXINGTON — BOARD OF PUBLIC WORKS
SEWER DIVISION

Sketch of Service Here

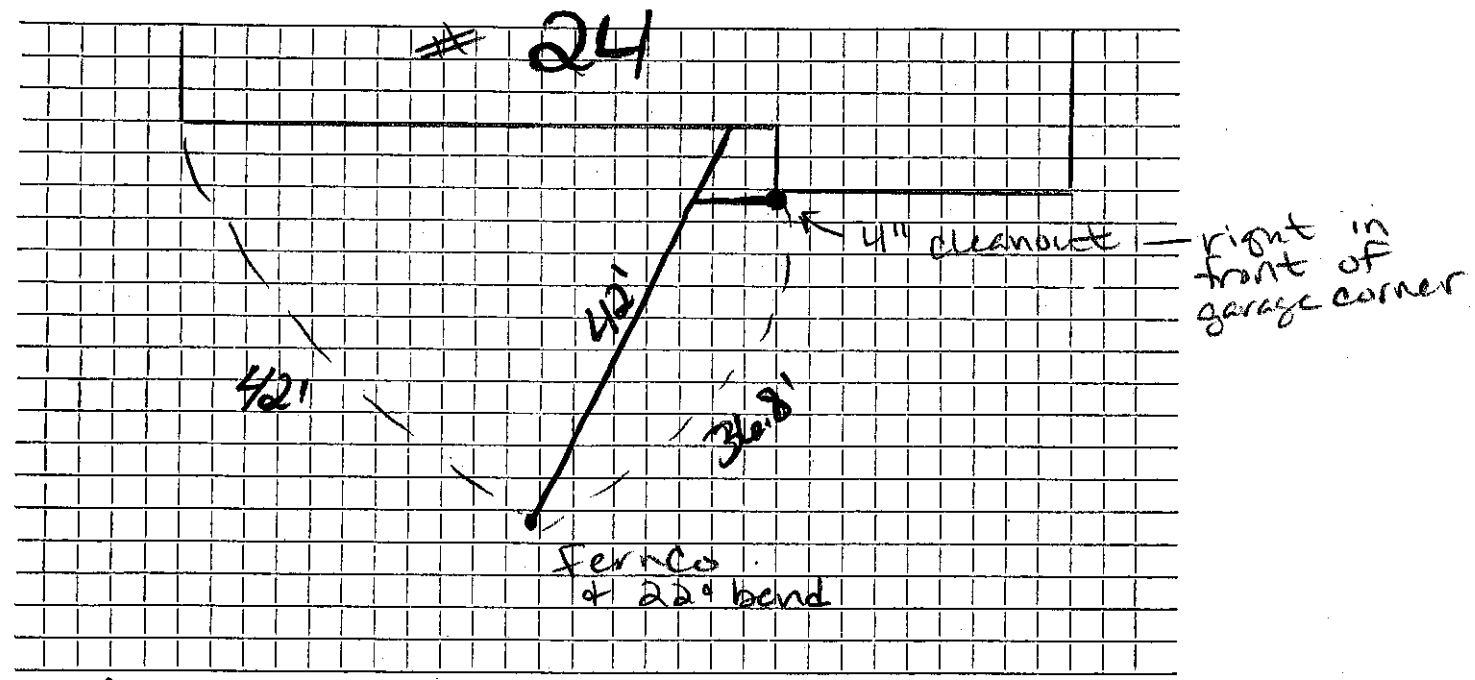

Connection made in Columbus Street. Work completed

Remarks:
..... Fernco to AC w/ 22° bend
.....