

Name Brothers Trust

Service No. 27

Address 22 Columbus Street

Lot #5 Vacant Lot

Location

Kind of Pipe

Size

Size of Main

~~Repair - Renewal~~

New Service

DeFlice permit #1844

Location

AUG 14 1972


| Date | Material | Amount | Total | Date | Amount |
|--------------------|---------------------------------------|--------|-------|--------------------|------------------|
| 4-30-65 | 14' 6" transite pipe @7.00 | | 98.00 | 4-24-71 | 98.00 |
| 11-16-78 | Renewal | | | | |
| | 10' 6" Transite | | | 4-30-65 | |
| | 2 6" Collars | | | 14' 6" Transite | |
| | 1 6" Sleeve Adapter | | | 11-16-78 | Renewal |
| | 1 6"-11 1/4" Elbow | | | 5' 6" Transite | |
| | | | | 11-15-78 | Roots 25 - 247 |

DATE _____

TOWN OF LEXINGTON — BOARD OF PUBLIC WORKS

SEWER DIVISION

Sketch of Service Here **22**

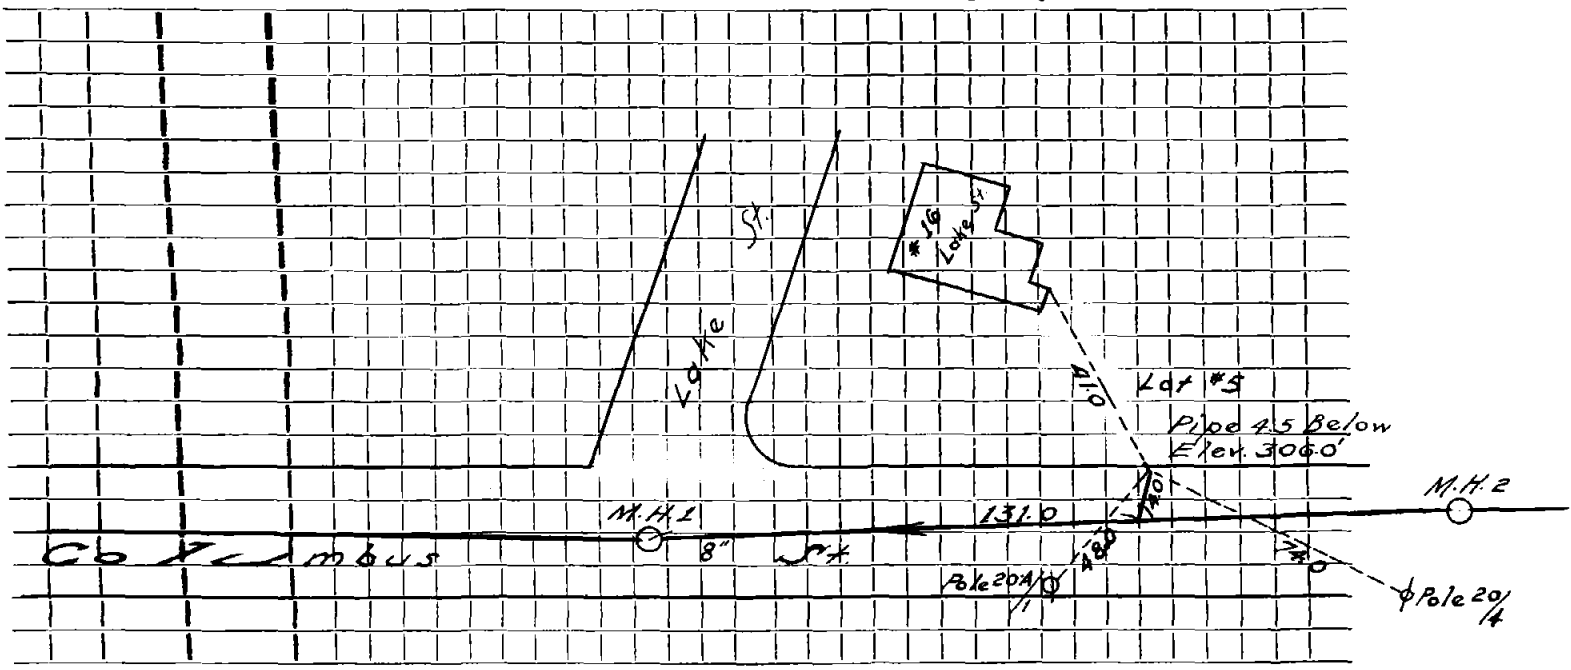

Connection made in _____ Street. Work completed _____

Remarks: _____

