

Name Edmund Maloney

Service No. 24

Address 23 Columbus Street

Location

Kind of Pipe

Size

Size of Main

Repair—Renewal—New Service Valeri #1500


Location APR 6 1970

Date	Material	Amount	Total	Date	Amount	
4-29-65 29'	6" Transite pipe @7.00		203.00	5-7-65	Deposit	203.00
12-5-69	32' 6" Transite pipe					
	10' 4" Cast Iron pipe			4-29-65		
					29' 6" Transite	

DATE _____

TOWN OF LEXINGTON — BOARD OF PUBLIC WORKS
SEWER DIVISION

Sketch of Service Here **23**

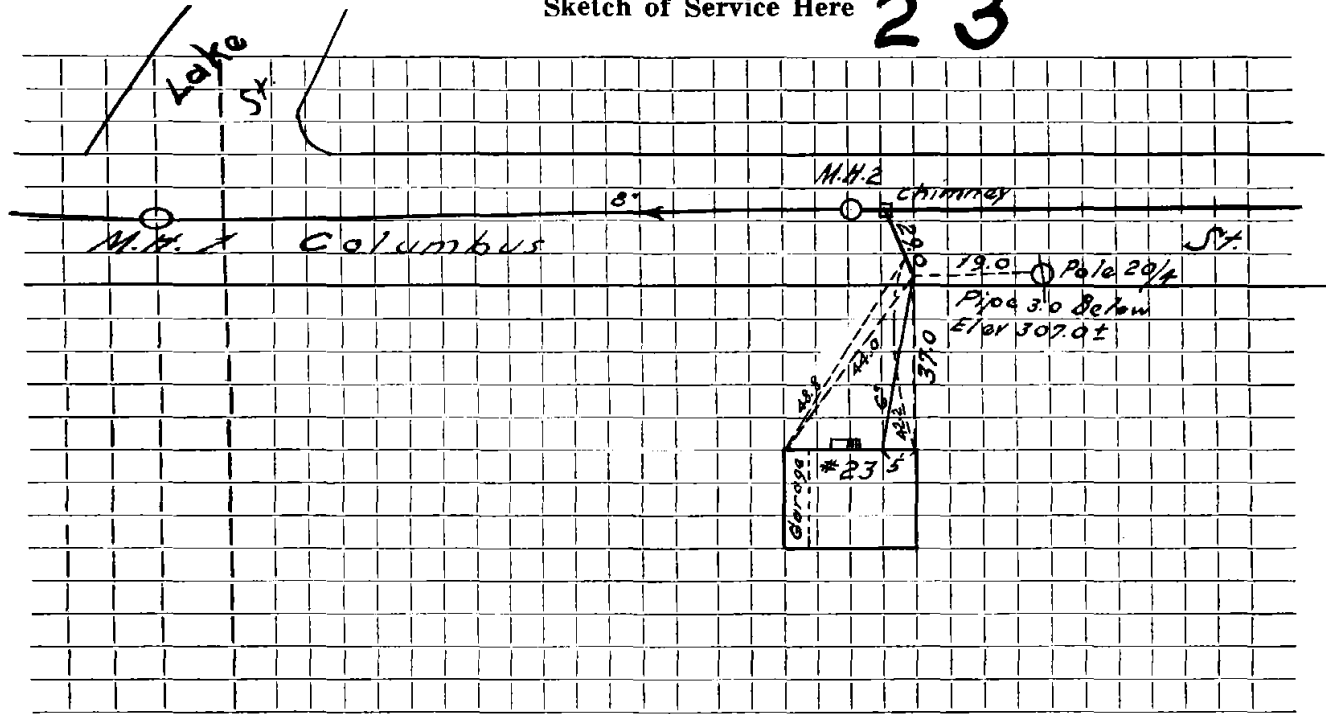

Connection made in Street. Work completed

Remarks:
.....
.....