

Name Harold Asp

Service No. 78

Address 25 Columbus Street

Location

Kind of Pipe

Size

Size of Main

Repair—Renewal—New Service Russell Sibley Permit #333

Location SEP 27 1965


Date	Material	Amount	Total	Date	Amount
2-29-65	28' 6" Transite pipe @7.00		196.00	4-14-65	Deposit
8-24-65	28½' 6" Transite pipe			4-29-65	
				28' 6" Transite	

DATE _____

TOWN OF LEXINGTON — BOARD OF PUBLIC WORKS

SEWER DIVISION

Sketch of Service Here **25**

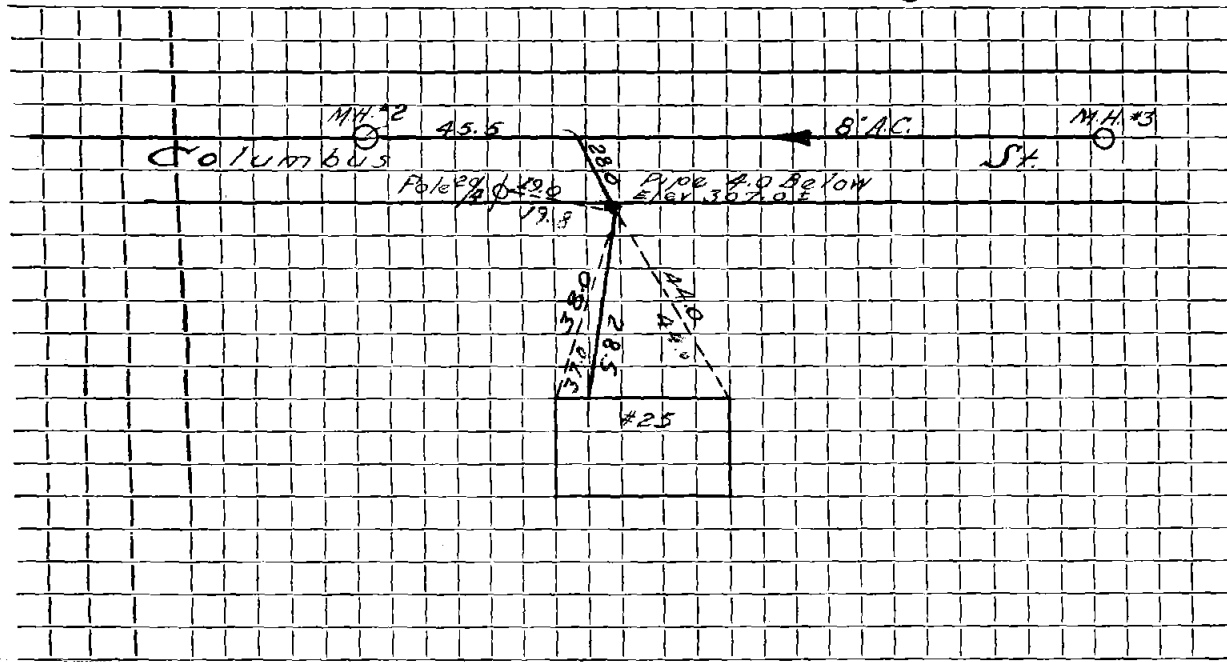

Connection made in Street. Work completed

Remarks:
.....
.....