

Name Murray MacMillan

Service No. 64

Address 31 Columbus Street

Location

Kind of Pipe

Size

Size of Main

~~Repair~~ ~~Renewal~~ New Service

Russell Sibley Permit #316

Location AUG 9 1965


Date	Material	Amount	Total	Date	Amount	
4-29-65	27' 6" Transite pipe @7.00		189.00	5-27-65	Deposit	189.00
7-8-65	45' 6" Transite pipe			4-29-65	27' 6" Transite	

DATE _____

TOWN OF LEXINGTON — BOARD OF PUBLIC WORKS

SEWER DIVISION

Sketch of Service Here **31**

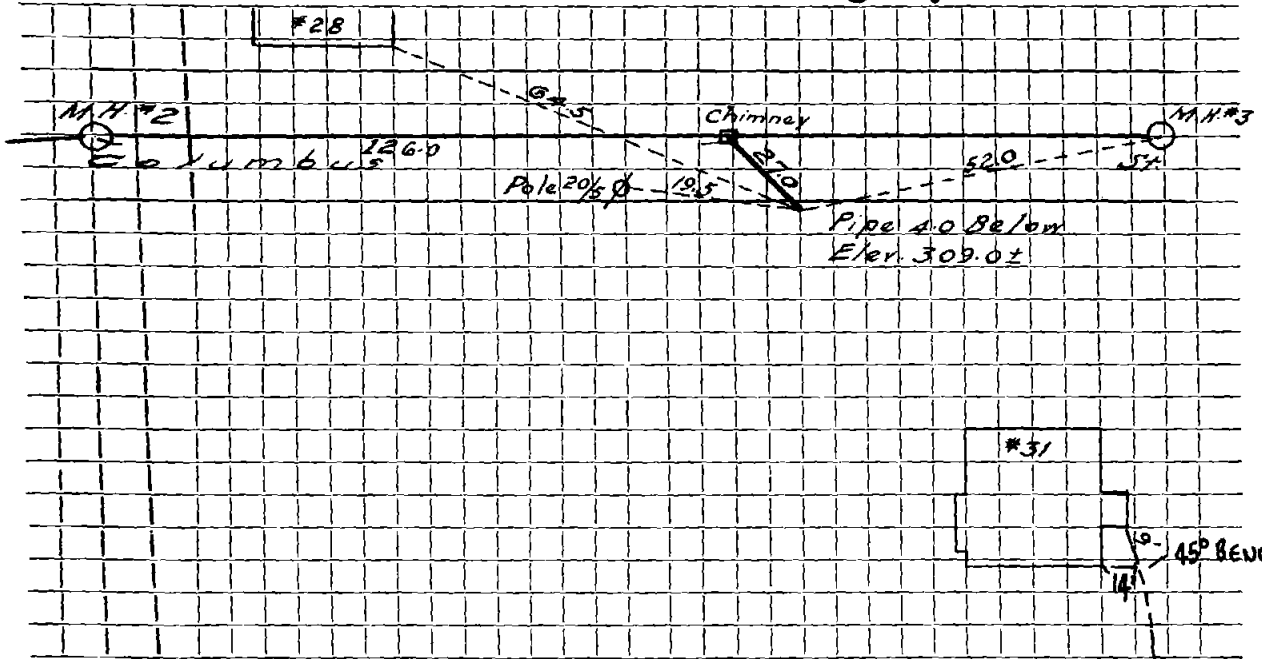

Connection made in Street. Work completed

Remarks:
.....
.....