

Name

Service No.

Address

33 Columbus St.

Location

Kind of Pipe

Size

Size of Main

Repair—Renewal—New Service

De Flice Bros. # 3133

Location

Date

Material

Amount

Total

Date

Amount

10-5-73


18' - 6" ACP

10' - 4" CI

DATE \_\_\_\_\_

TOWN OF LEXINGTON — BOARD OF PUBLIC WORKS  
SEWER DIVISION

Sketch of Service Here **33**

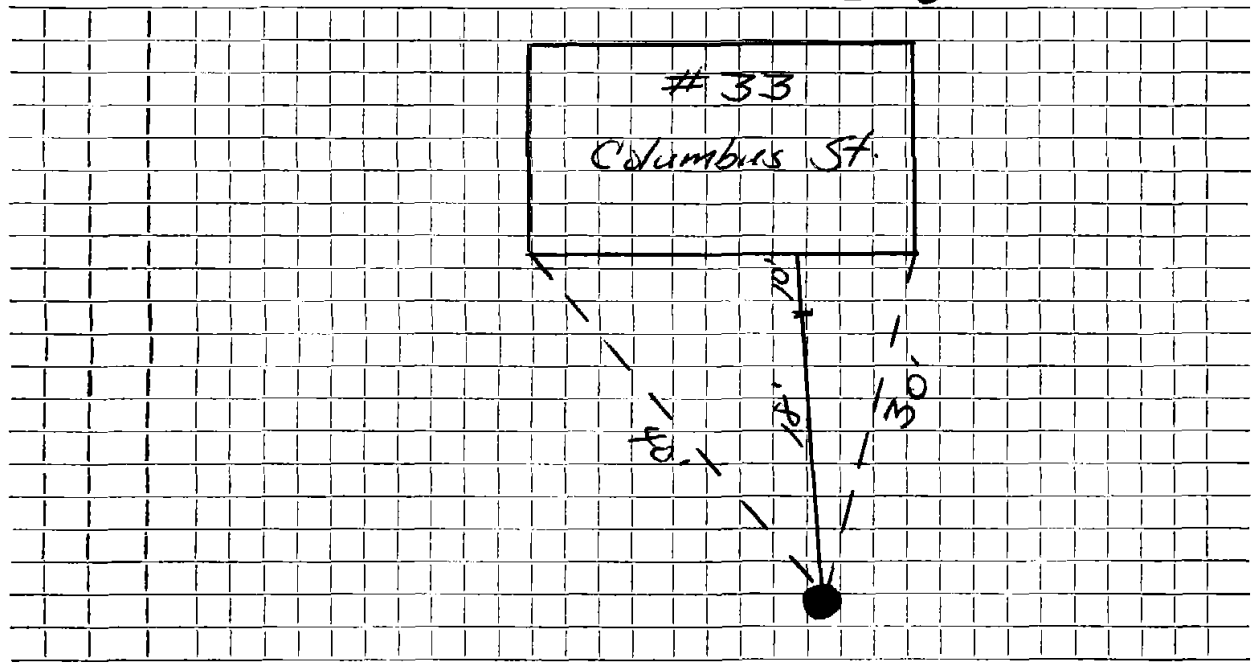

Connection made in ..... Street. Work completed .....

Remarks: .....  
.....  
.....