

Name Joseph Curra

Service No. 113

Address 5 Columbus Street

Location

Kind of Pipe

Size

Size of Main

Repair—Renewal—New Service

Dr. Police #2759

Location

OCT 25 1976

Date

Material

Amount

Total

Date

Amount

5-3-65 11' 6" Transite pipe @7.00

77.00

11-3-75

Deposit


77.00

DATE _____

TOWN OF LEXINGTON — BOARD OF PUBLIC WORKS

SEWER DIVISION

Sketch of Service Here **5**

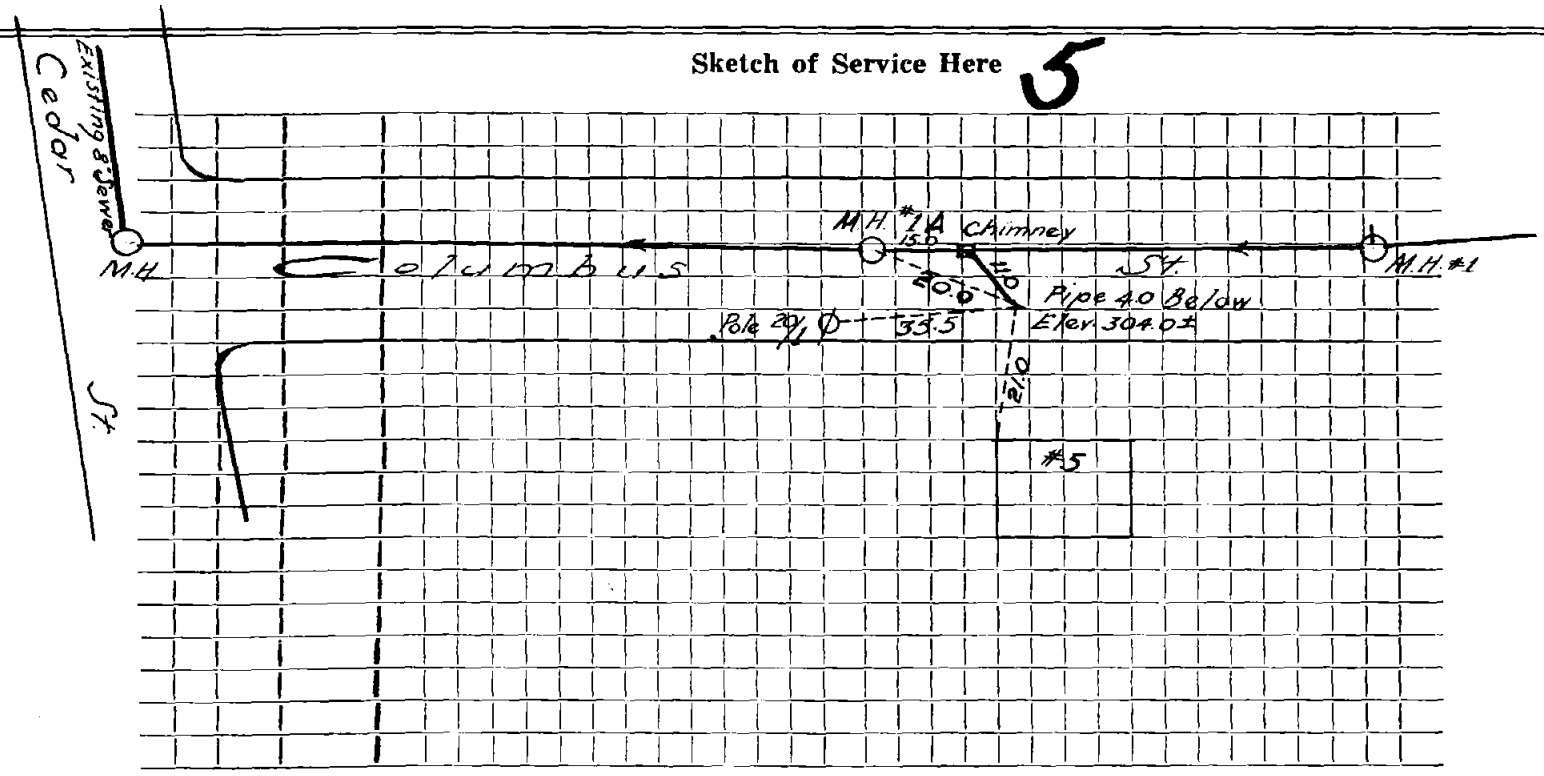

Connection made in Street. Work completed

marks :
.....
.....