

Name Louis C. Bently, Jr.

Service No. 121

Address 8 Columbus Street

Location

Kind of Pipe

Size

Size of Main

Repair—Renewal—New Service

Dr. Price # 2766

Location

OCT 25 1976

Date	Material	Amount	Total	Date		Amount
5-3-65	14" 6" Transite pipe @7.00		98.00	<i>10-29-76</i>	<i>Deposit</i>	<i>98.00</i>

H. B. M. 18501




DATE _____

TOWN OF LEXINGTON — BOARD OF PUBLIC WORKS

SEWER DIVISION

Sketch of Service Here

8

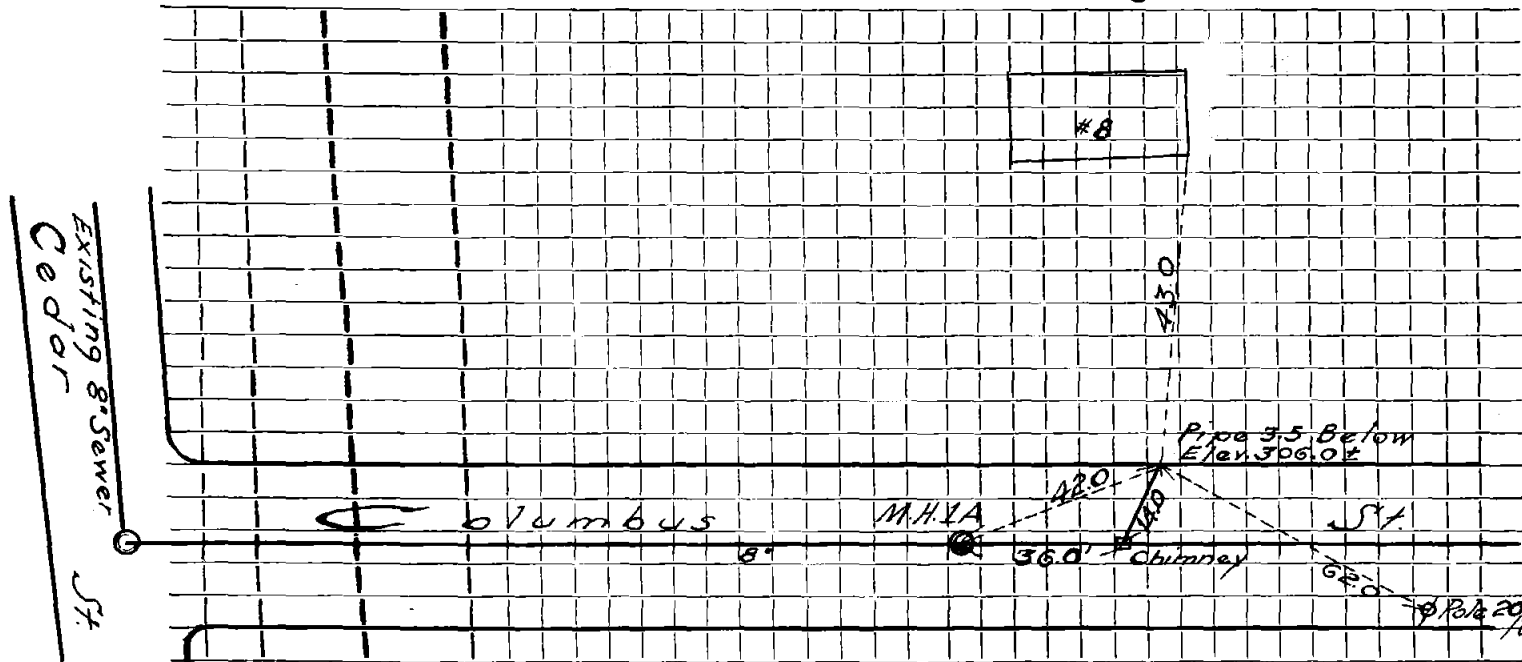

Connection made in _____ Street. Work completed _____

Remarks: _____

