

Name

Service No.

Address

Columbus Street

Lot #8 Vacant Lot

#30

Location

Kind of Pipe

Size

Size of Main

Repair—Renewal—New Service

Location

Date

Material

Amount

Total

Date

Amount

4-29-65 10' 6" Transite pipe @7.00 70.00

9/10/73 SERVICE CAN NOT BE

USED. No CHARGE


*(Signature)*

DATE \_\_\_\_\_

# TOWN OF LEXINGTON — BOARD OF PUBLIC WORKS

## SEWER DIVISION

Sketch of Service Here

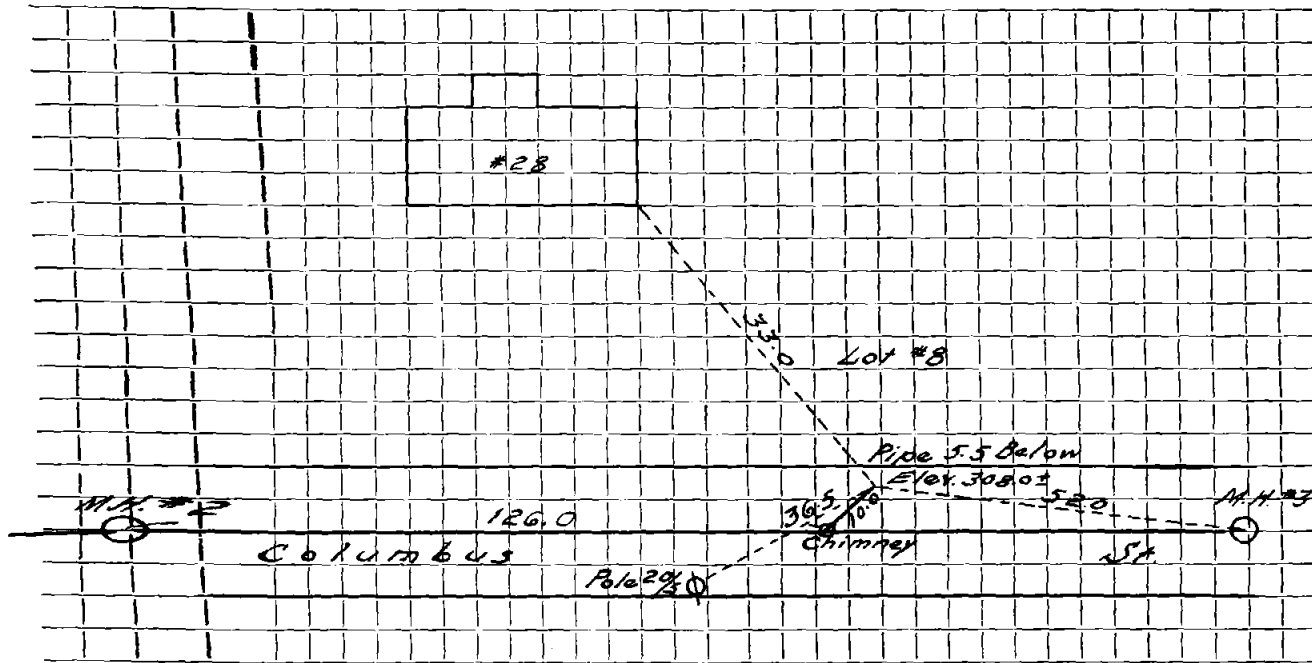

Connection made in \_\_\_\_\_ Street. Work completed \_\_\_\_\_

Remarks: *Shown for To be used for #28 Columbus Street*