

Name Stanley S. Miller

Service No. 203

Address 3 Compton Circle

Location 3 Compton Circle

Kind of Pipe

Size

Size of Main

~~REGISTRATION~~ New Service

W.O.# 8352

Location

JUN 29 1964


Date	Material	Amount	Total	Date	Amount
3-3-64	Labor	100.28		11-29-63	450 00
3-4-64	"	80.26			
4-4-64	"	15.77	196.31	11-23-64	32 93
	10% O.H.		19.63		482 93
	64' 6" Transite pipe @.82		52.48		
1	1 1/4" Transite Bend		4.09		
1	6" Duplex Adapter		1.62		
	200 Sewer Brick @4.20 per 100		8.40		
2	bags Cement @1.50		3.00		
1	20" Cesspool Cover & Frame		10.50		
2	yds. Loam @2.00		4.00		
1	ton Sand		1.10		26.3 feet 6" A.C.
1	hr. Compressor @5.00		5.00		installed by contractor
2	hrs. Town Shovel @6.50		13.00		@ 6.00 per foot
2	hrs. Trucking @3.00		6.00		157 80
	Previous Charge		157.80		
			482.93		

Bill 5- - 32.93

DATE \_\_\_\_\_

**TOWN OF LEXINGTON — BOARD OF PUBLIC WORKS**  
**SEWER DIVISION**

Sketch of Service Here **3**

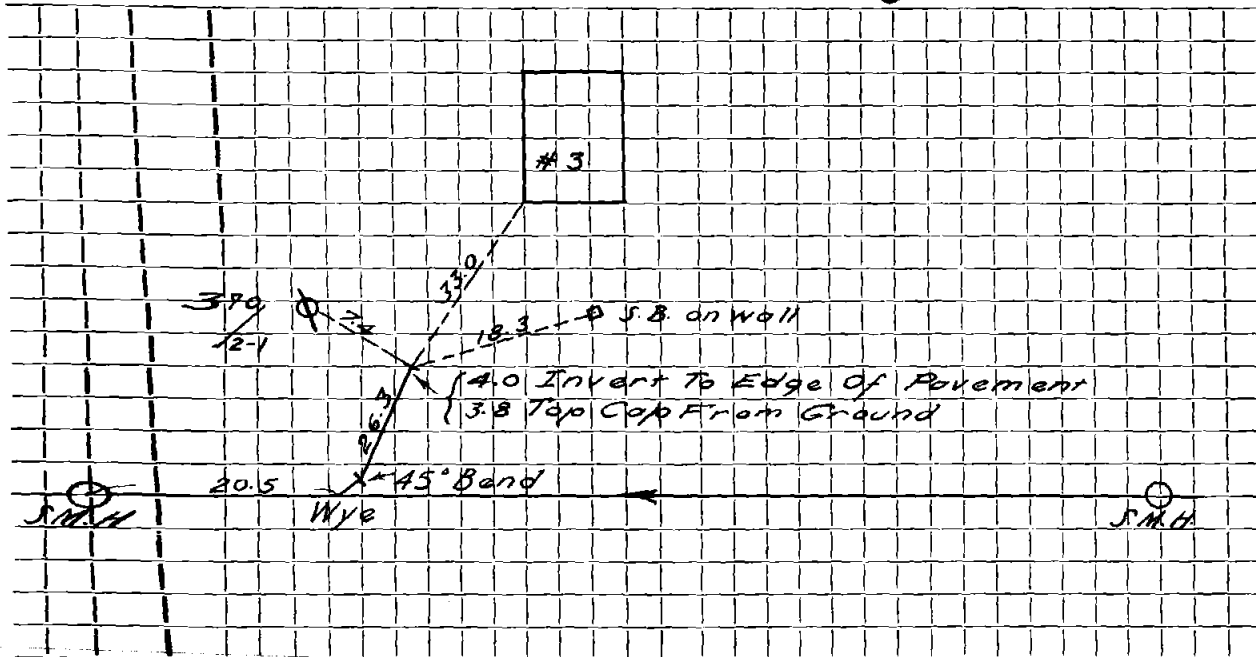

Connection made in ..... Street. Work completed .....

Remarks: .....  
.....  
.....