

Name Bernard A. Kriegsman

Service No. 205

Address 4 Compton Circle

Location

Kind of Pipe

Size

Size of Main

~~REPAIR~~ ~~REPAIR~~ ~~REPAIR~~ - New Service

W.O.# 8354

Location


Com 6-29-64

Date	Material	Amount	Total	Date	Amount
1-23-64	Labor	80.26		11-29-63	300 00
5-11-64	"	11.32	91 58	6-29-64	22 48
	10% O.H.	9 16	100 74		177 52
	30'6" Transite Pipe @.82		24 60		
	1 Bag Cement		1 50		
	1 90° Transite Elbow		4 09		
	1 11¼° Transite Bend		4 09		
	2 Yards Loam @2.00		4 00		
	5 Hrs. Town Shovel @6.50		32 50		
	2 Hrs. Trucking @3.00		6 00		
			177 52		

DATE _____

TOWN OF LEXINGTON — BOARD OF PUBLIC WORKS
SEWER DIVISION

Sketch of Service Here **4**

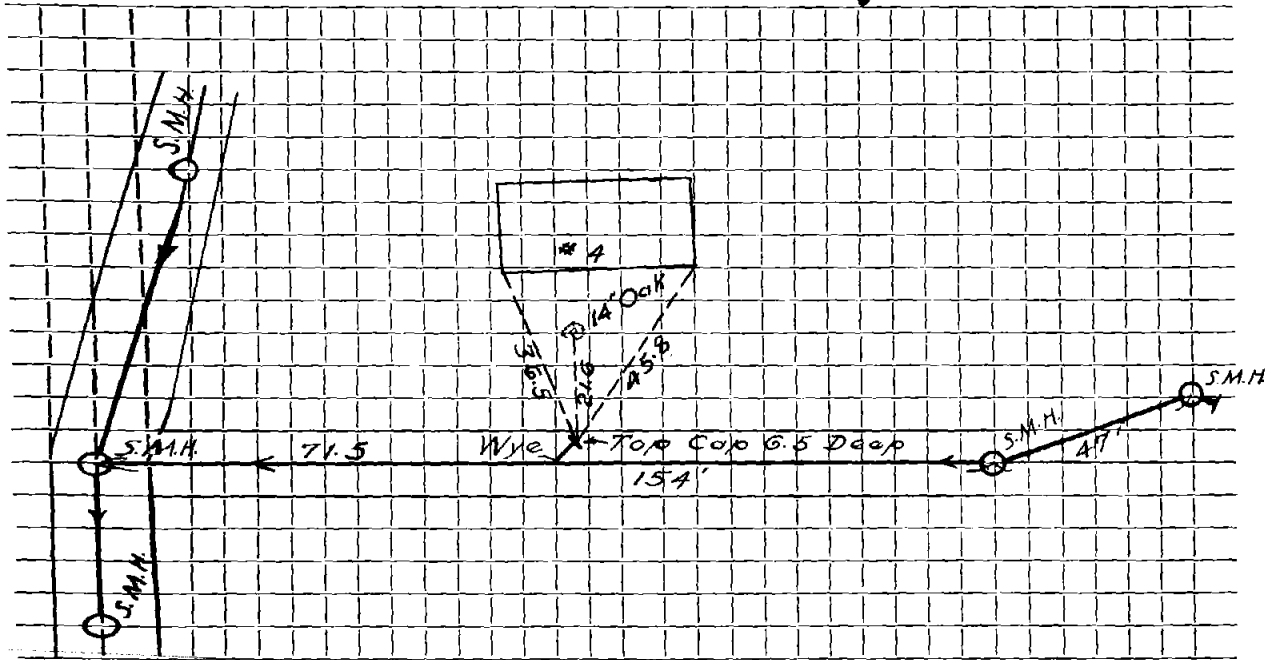

Connection made in Street. Work completed

Remarks:
.....
.....