

Name C. M. Touart

Service No.

Address 5 Compton Circle

Location

Kind of Pipe

Size

Size of Main

Repair—Renewal—New Service Brucchi #1707


Location

Date	Material	Amount	Total	Date	Amount
8-21-70	45' 6" Transite pipe				
	18' 4" Cast Iron pipe				

DATE \_\_\_\_\_

**TOWN OF LEXINGTON — BOARD OF PUBLIC WORKS**  
**SEWER DIVISION**

Sketch of Service Here

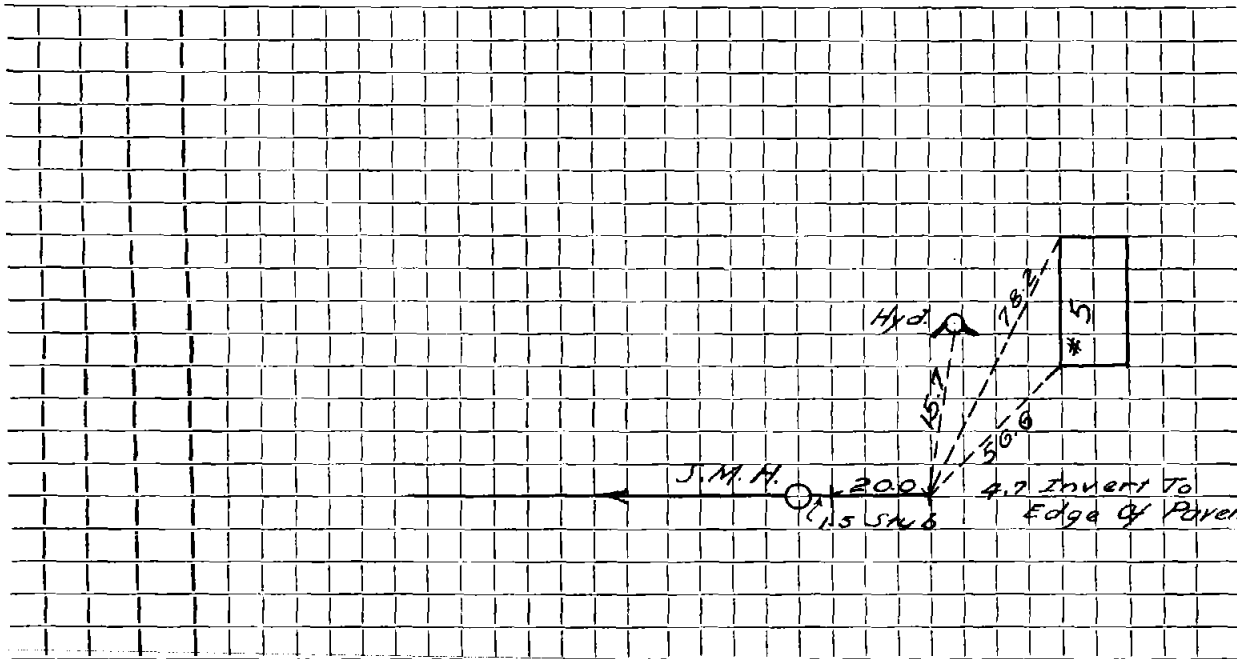

Connection made in ..... Street. Work completed .....

Remarks: .....  
.....  
.....

Name C. N. Touart

Service No. 201

Address 5 Compton Circle

Location 5 Compton Circle

Kind of Pipe

Size

Size of Main

~~Repair of Sewer~~ New Service 100 # 8347

Location JUN 29 1964


Date	Material	Amount	Total	Date	Amount
1-7-64	Labor	90.91		11-26-64	360 00
5-13-64	"	37.76	128.67	10-16-64	2 19
	10% O.H.	12.87	141.54		362 19
	58' 6" Transite pipe @.82		47.56		
	1 11 1/4" Transite Bend		4.09		
	1 bag Cement		1.50		
	3 yds. Loam @2.00		6.00		
	5 hrs. Town Shovel @6.50		32.50		
	3 hrs. Trucking @3.00		9.00		
	Previous Charge		<u>120.00</u>	20.0 feet 6" A.C. installed by contractor @ 6.00 per foot	120 00
			362.19		

*Balance 219*

DATE \_\_\_\_\_

# TOWN OF LEXINGTON — BOARD OF PUBLIC WORKS

## SEWER DIVISION

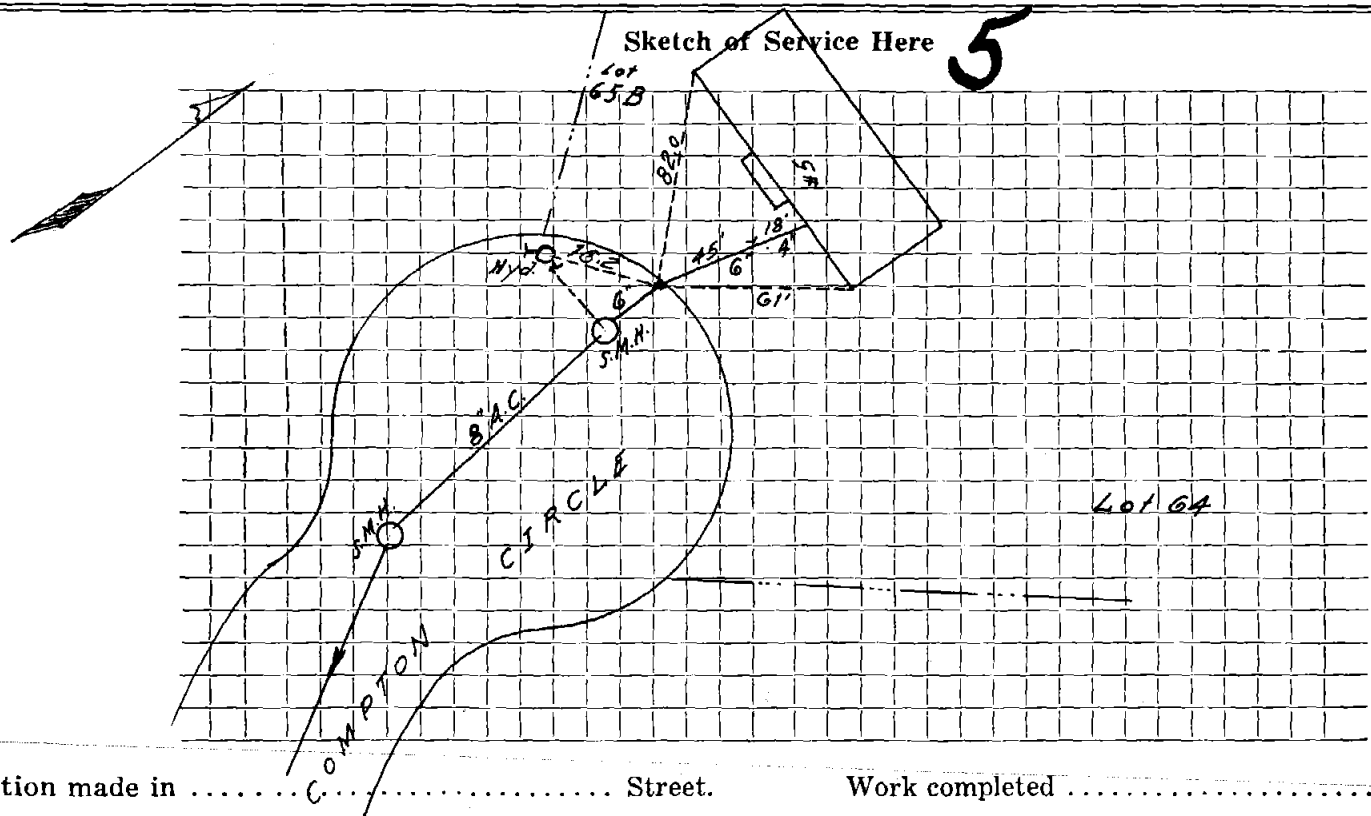

Connection made in ..... Street. Work completed .....

Remarks: .....  
.....  
.....