

Name Kivio Moldave

Service No. 78

Address 6 Compton Circle

Location

Kind of Pipe

Size

Size of Main

~~Repair~~ New Service

W.O.# 8727

Location

JUN 29 1964


Date	Material	Amount	Total	Date	Amount
6-1-64	Labor	108.82		5-5-64	400.00
6-2-64	"	32.85	141.67	6-29-64	98.33
	10% O.H.	14.17	155.84		301.67
	82' 6" Transite Pipe @.82		67.24		
	1 Bag Cement		1.50		
	1 11 1/4° Transite Bend		4.09		
	11 Yards Loam @2.00		22.00		
	6 Hrs. Town Shovel @6.50		39.00		
	4 Hrs. Trucking @3.00		12.00		
			301.67		

DATE \_\_\_\_\_

**TOWN OF LEXINGTON — BOARD OF PUBLIC WORKS**  
**SEWER DIVISION**

Sketch of Service Here

6

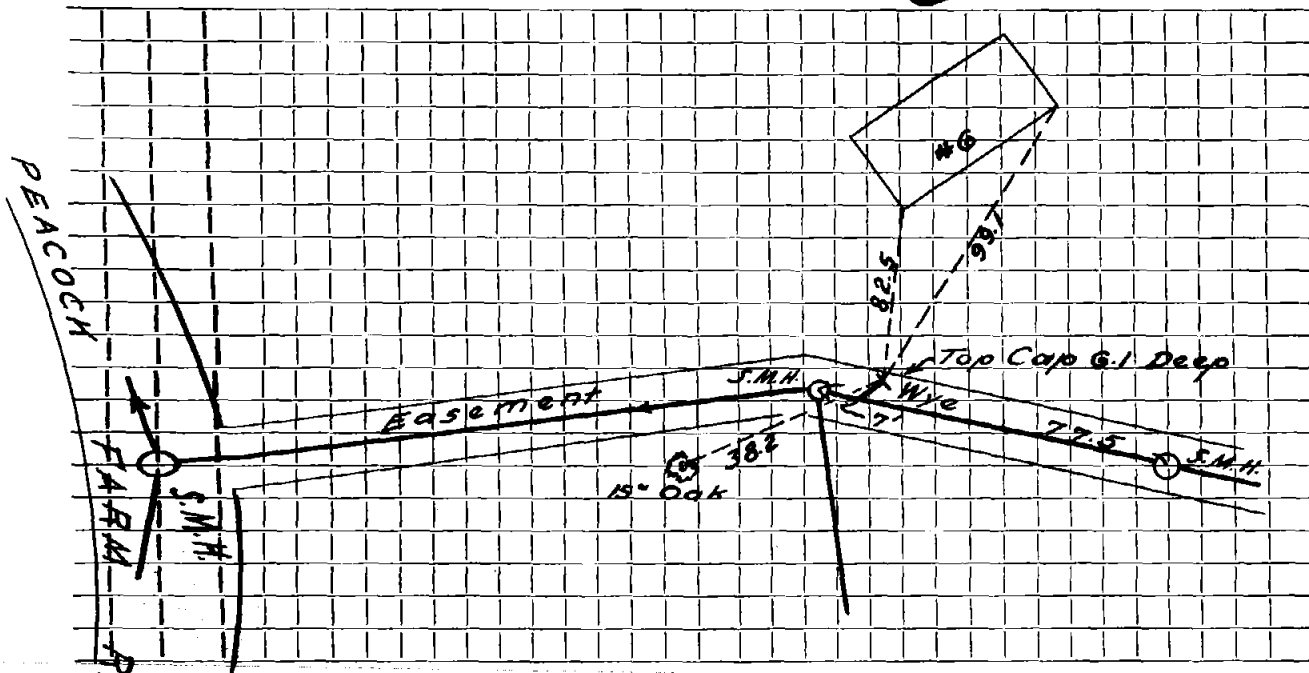

Connection made in ..... Street. Work completed .....

Remarks: .....  
.....  
.....