

Name

Service No.

Address *LOT #1 CONCORD AVE.*

Location

Kind of Pipe *PVC*

Size *6"*

Size of Main *8"*

Repair—Renewal—New Service

Location


Date	Material	Amount	Total	Date		Amount
10-3-80	33' 6" PVC @	14.00 =	\$462.00			
				<i>10-3-80</i>		
					<i>33' 6" PVC.</i>	



DATE 11-18-80

TOWN OF LEXINGTON — BOARD OF PUBLIC WORKS
SEWER DIVISION

Sketch of Service Here

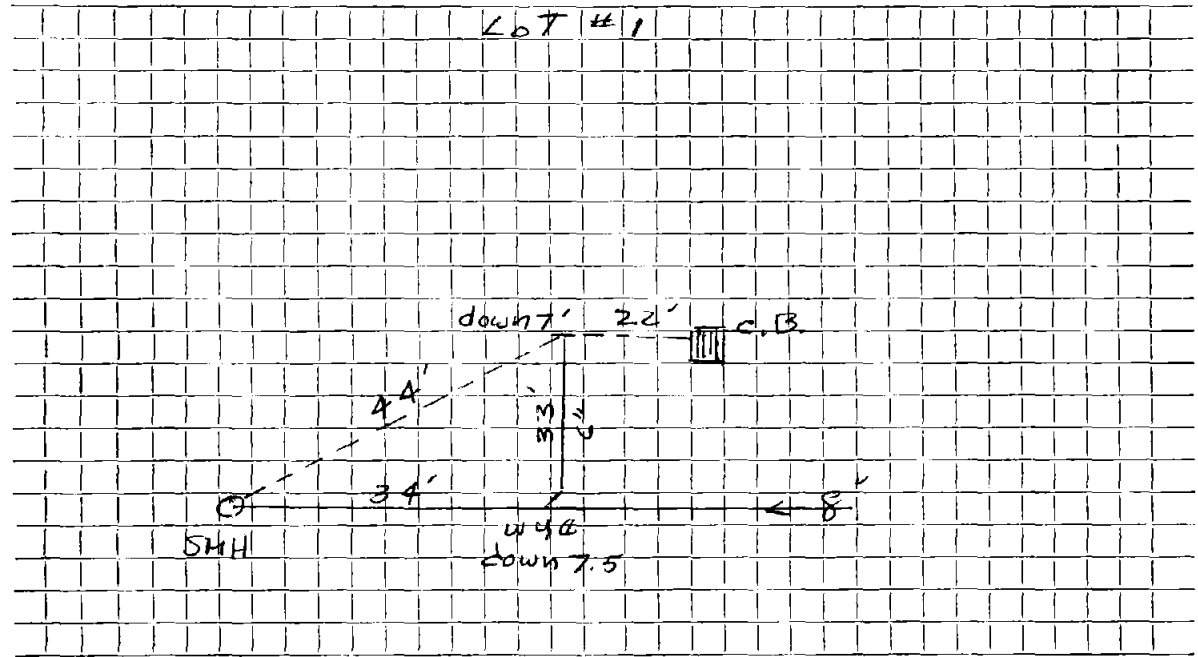

Connection made in CONCORD AVE. Street. Work completed

Remarks: