


DATE 11-18-80

TOWN OF LEXINGTON — BOARD OF PUBLIC WORKS
SEWER DIVISION

Sketch of Service Here **100**

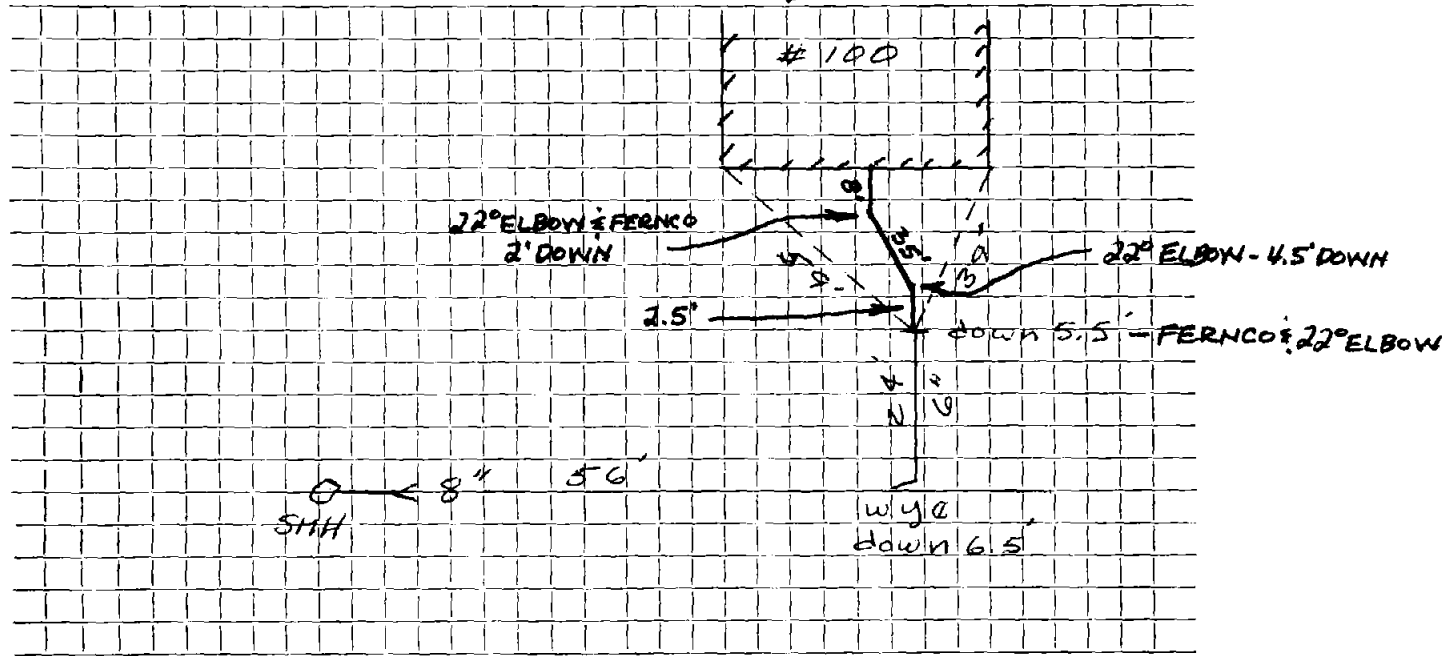

Connection made in CONCORD AVE. Street. Work completed

Remarks:

BOOK 97-3

J.W.