

Name George Kazazian

Service No. 27

Address #113-115 CONCORD AVE

Location

Kind of Pipe PVC

Size 6"

Size of Main 8"

~~Repair~~ ~~Renewal~~ New Service Valeri #3748

Location

OCT 25 1982

| Date | Material | Amount | Total | Date | Amount |
|--------------------|---------------------------|-------------------|--------------|-------------------|-------------------|
| 10-6-80 | 29' x 6" PVC @ | \$1400 | = | \$3148 | 416.00 |
| 9/21/82 | 106' 6" P.V.C. Pipe | | \$406.00 | | |
| | 3 22½° P.V.C. Elbow | | | 10-6-80 | |
| | 1 6" P.V.C. Wye | | | 29' 6" PVC. | |
| | 1 6" P.V.C. 45° Bend | | | | |
| | 1 4" x 6" Donut | | | | |
| | | | | | |
| | | | | | |



DATE 11-18-80

TOWN OF LEXINGTON — BOARD OF PUBLIC WORKS
SEWER DIVISION

Sketch of Service Here

113-115

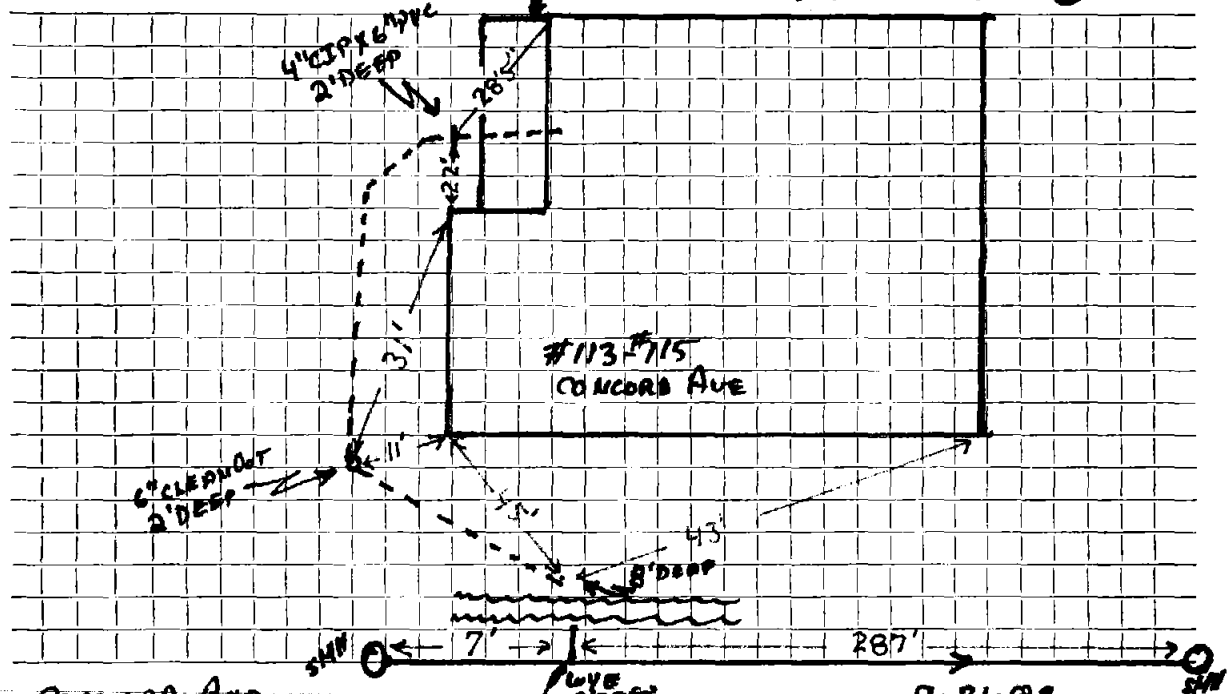

Connection made in CONCORD AVE Street. Work completed 9-21-82

Remarks: 29' X 6" PVC PIPE FROM MAIN TO PROPERTY LINE

.....
.....