




DATE 11-18-80

TOWN OF LEXINGTON — BOARD OF PUBLIC WORKS  
SEWER DIVISION

Sketch of Service Here **116**

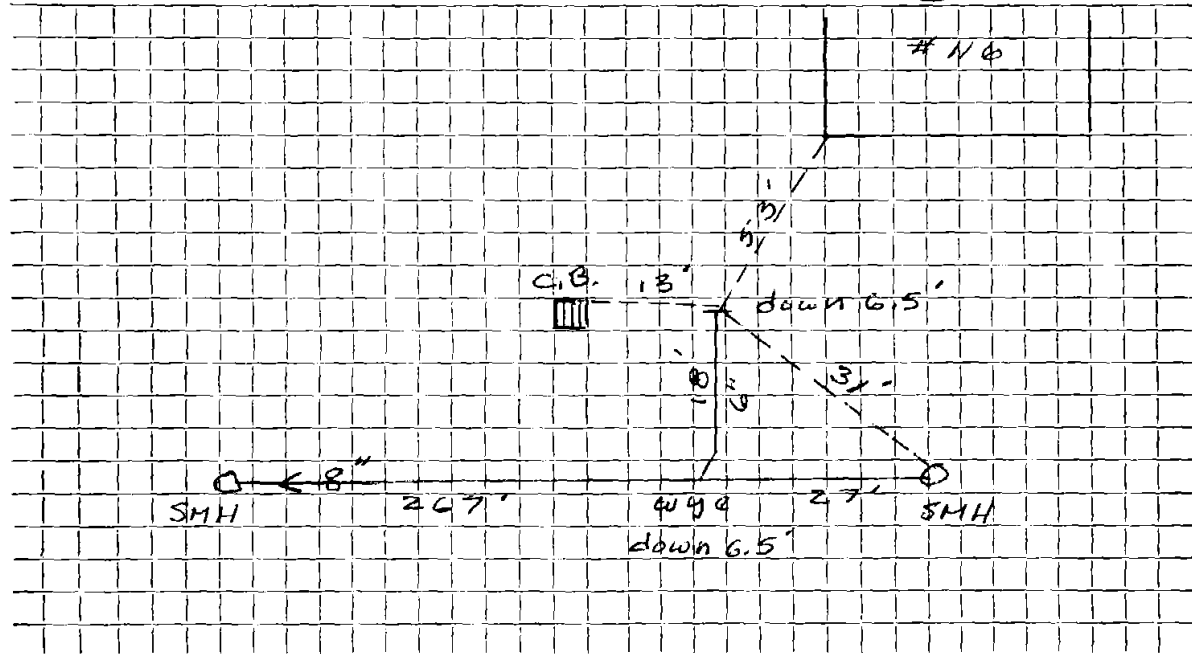

Connection made in CONCORD AVE. Street. Work completed .....

Remarks: .....  
.....  
.....