

Name

Service No.

Address 119 Concord AVE

Permit # 1382

Location

Kind of Pipe

Size

Size of Main

Repair—Renewal—New Service

Location

Date

Material

Amount

Total

Date

Amount

6/2/00

Inside

100' 6" PVC Pipe

1 6" 45° Bend

104' 6" PVC

6' 6" 45° CLEAN OUT


20' 6" PVC



DATE 6/2/00

TOWN OF LEXINGTON — BOARD OF PUBLIC WORKS
SEWER DIVISION

Sketch of Service Here

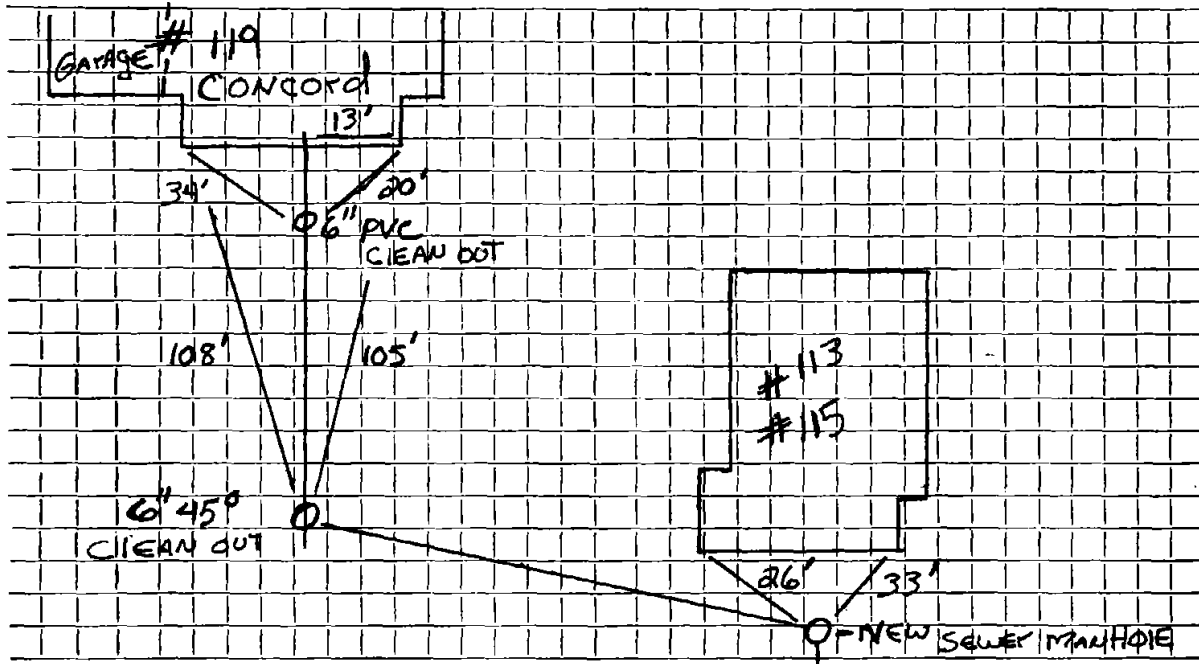

Connection made in Street. Work completed

Remarks:

.....
.....