

Name GLEN LEGERE

Service No.

Address 124 CONCORD AVE

Location

Kind of Pipe PVC

Size 6"

Size of Main 8"

Repair—Renewal

New Service

— PERMIT NO. 0979- J.M. MCLAUGHLIN

Location

Date	Material	Amount	Total	Date	Amount
------	----------	--------	-------	------	--------

10-6-80	21 1/2" PVC @	14.00	=	#294.00	
--------------------	--------------------------	------------------	--------------	--------------------	--

10-6-80	21 1/2" PVC @	14.00	=	#294.00	
6/30/1977	130' - 6" Ø PVC				
	2- 90° SWEEPS				
	1- 22° ELBOW				

JUNE 30, 1997

DATE 11-18-80

TOWN OF LEXINGTON — BOARD OF PUBLIC WORKS

90° SWEEP
CLEANOUT


SEWER DIVISION

90° SWEEP
CLEANOUT

Sketch of Service Here
22° ELBOW

DECK

4" x 6" FERMC

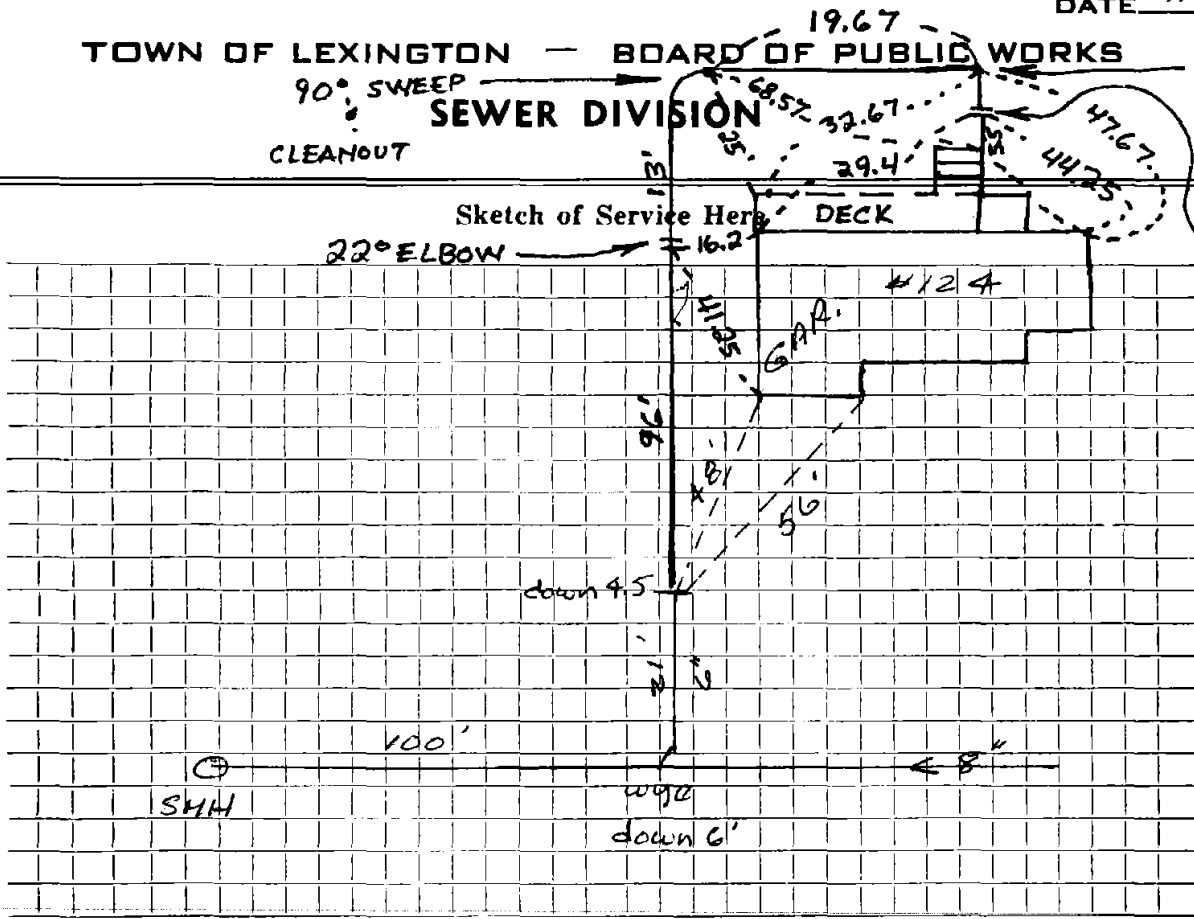

Connection made in CONCORD AVE. Street. Work completed

Remarks:

BOOK 97-2

J.W.