

Name *Windemere Group*

Service No.

Address *127 CONCORD AVE*

Lot 4

Location

Kind of Pipe

Size

Size of Main

Repair—Renewal—New Service

NEW BANKS # 0251

Location


Date	Material	Amount	Total	Date	Amount
<i>6/23/93</i>	<i>10 LF 4" PVC</i>			<i>6-23-93</i>	<i>364.00</i>
	<i>110.5 6" PVC</i>				
	<i>6x6" WYE C.O.</i>			<i>10-15-80</i>	
	<i>6"-22° ELBOW</i>			<i>26'</i>	<i>6" PVC</i>
	<i>4"x6" FERNCO</i>				
	<i>6x6" FERNCO</i>				
<i>10-15-80</i>	<i>26' 6" PVC @ 14.00</i>		<i>364.00</i>		

paid

DATE 1/5/94

TOWN OF LEXINGTON — BOARD OF PUBLIC WORKS
SEWER DIVISION

Sketch of Service Here

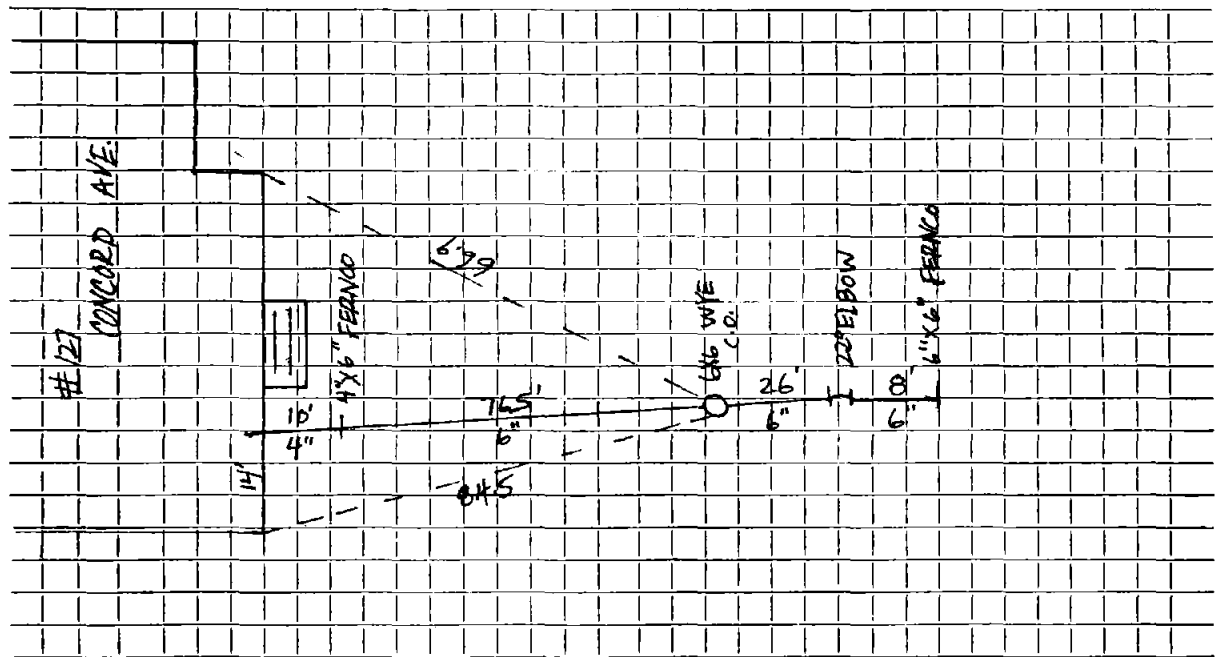

Connection made in Street. Work completed 6/23/93 E.R. BANKS.....

Remarks:
.....
.....