


Date: May 2023

TOWN OF LEXINGTON - BOARD OF PUBLIC WORKS
SEWER DIVISION

SKETCH OF SERVICE HERE
130 Concord Ave

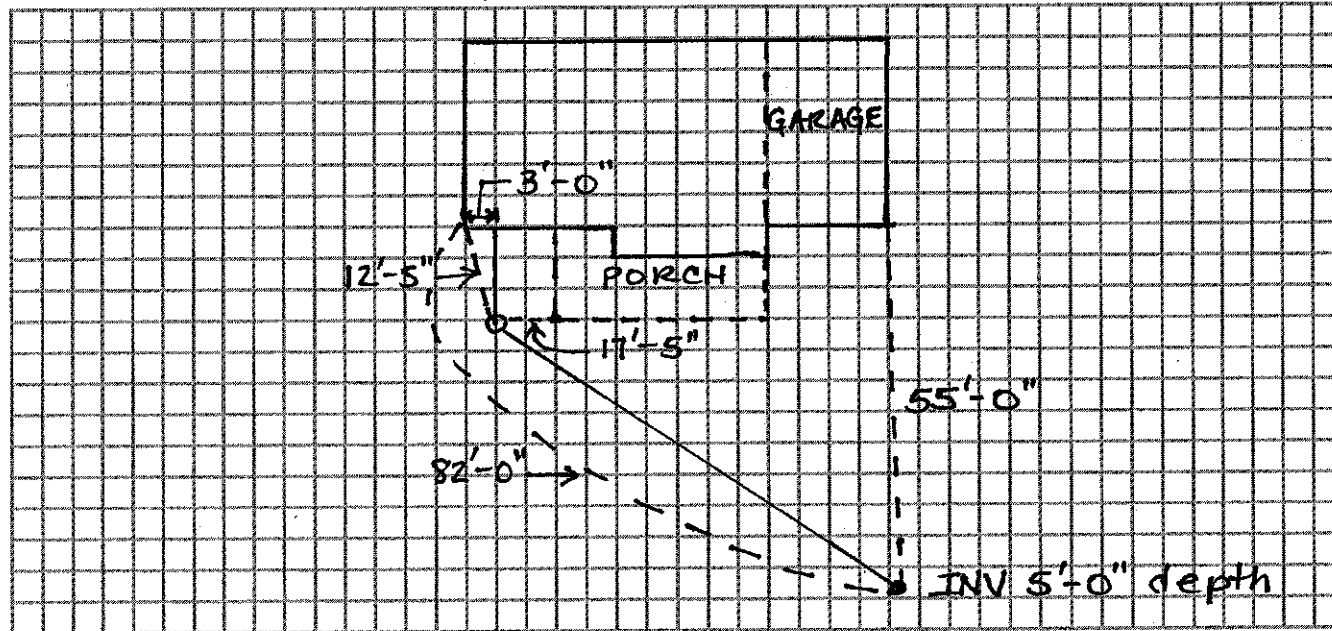

Connection made in:

Street.

Work completed:

Remarks: Installed by J.M. McLaughlin Inc.