


DATE _____

TOWN OF LEXINGTON — BOARD OF PUBLIC WORKS
SEWER DIVISION

143

Sketch of Service Here

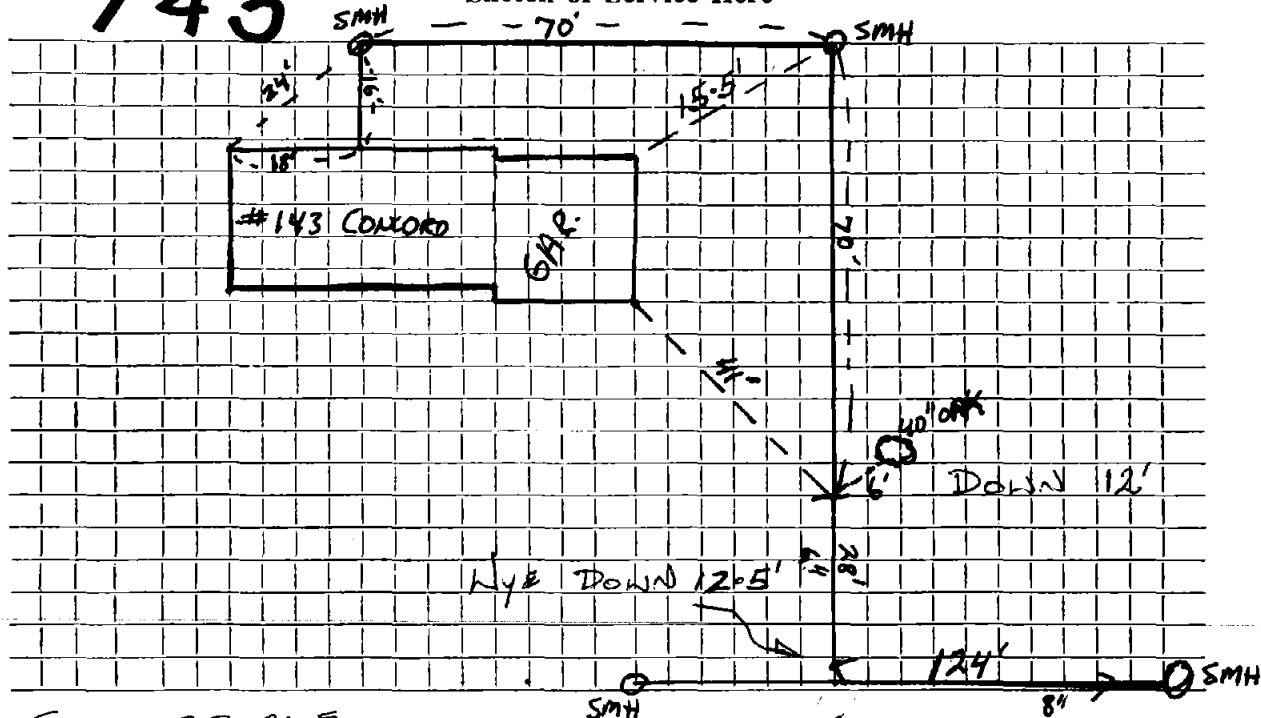

Connection made in CONCORD AVE. Street. Work completed

Remarks:

.....