




DATE July 7, 1976

TOWN OF LEXINGTON — BOARD OF PUBLIC WORKS  
SEWER DIVISION

Sketch of Service Here **150**

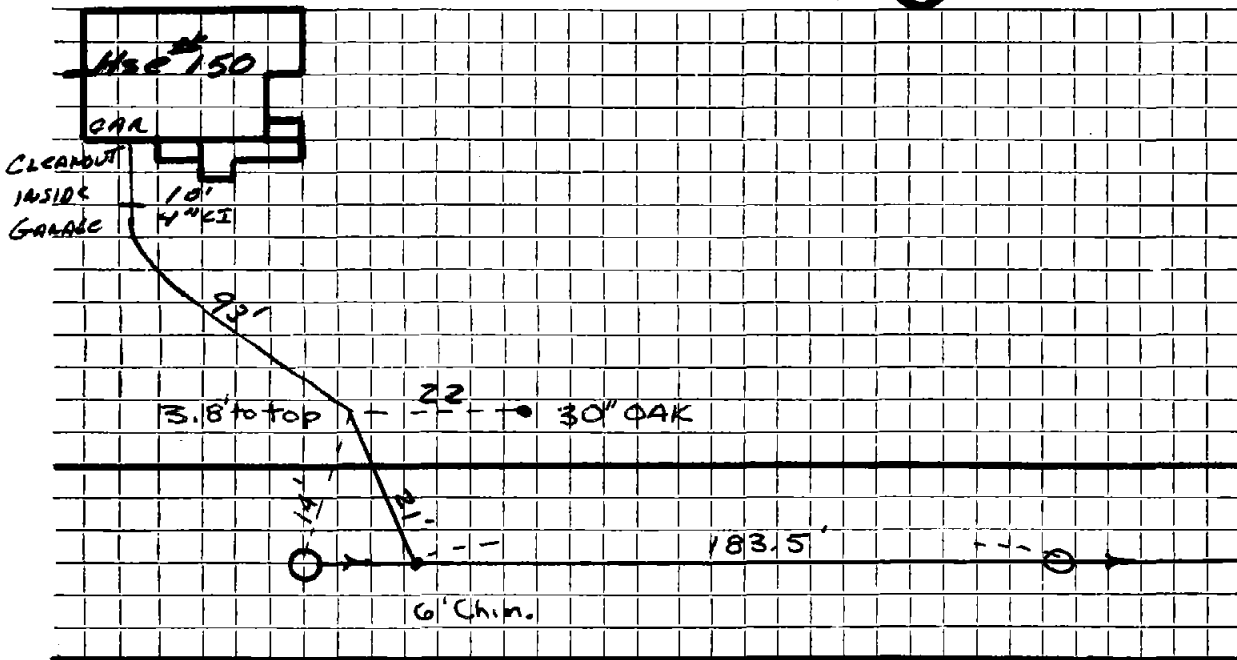

Connection made in CONCORD AVE Street. Work completed .....

Remarks: .....

.....  
.....