

Name

Service No.

Address 155 CONCORD AVE

Location

Kind of Pipe

Size

Size of Main

Repair—Renewal—New Service

Location

Date

Material

Amount

Total

Date

Amount

7-78 27'-6" ACP; 10'-4" CI

7-12-76


29' 6" A.C.

DATE _____

TOWN OF LEXINGTON — BOARD OF PUBLIC WORKS

SEWER DIVISION

Sketch of Service Here **155**

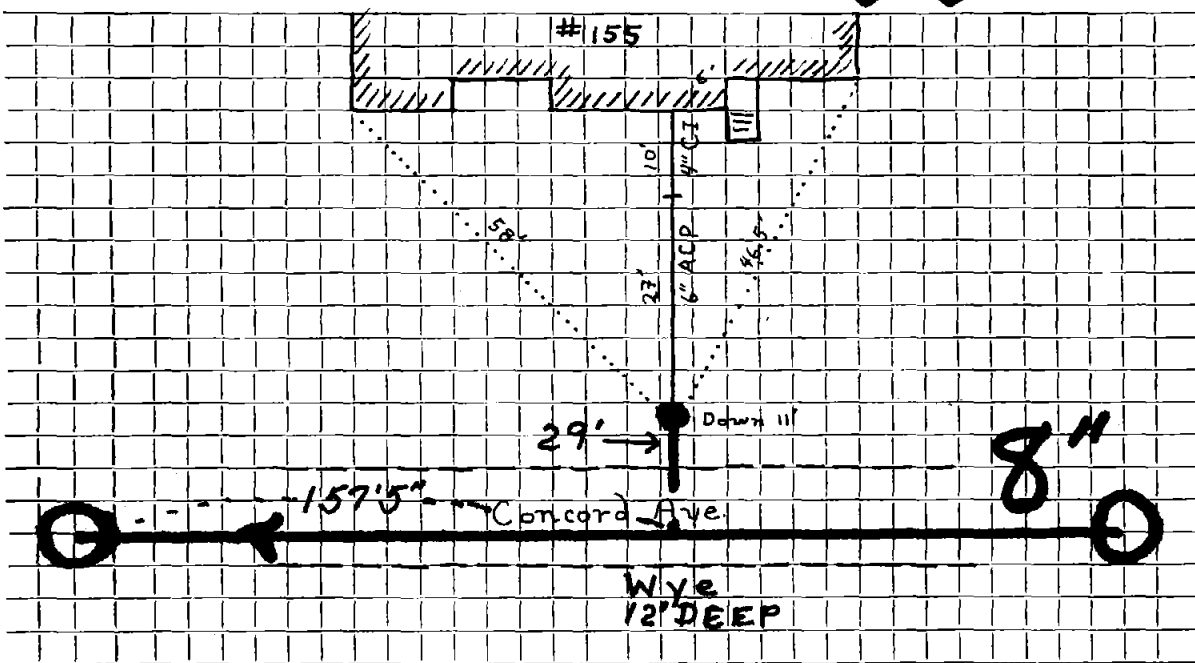

Connection made in Street. Work completed

Remarks:
.....
.....