

Name

Service No.

Address

(156)

Location

Kind of Pipe

AC

Size

6"

Size of Main

8"

Repair—Renewal—New Service


Location

Date	Material	Amount	Total	Date	Amount
Jul 1 76	11' 6" A.C. @ 10	110 -			
				7-1-76	
				11' 6" A.C.	

DATE July 1, 1976

TOWN OF LEXINGTON — BOARD OF PUBLIC WORKS
SEWER DIVISION

Sketch of Service Here

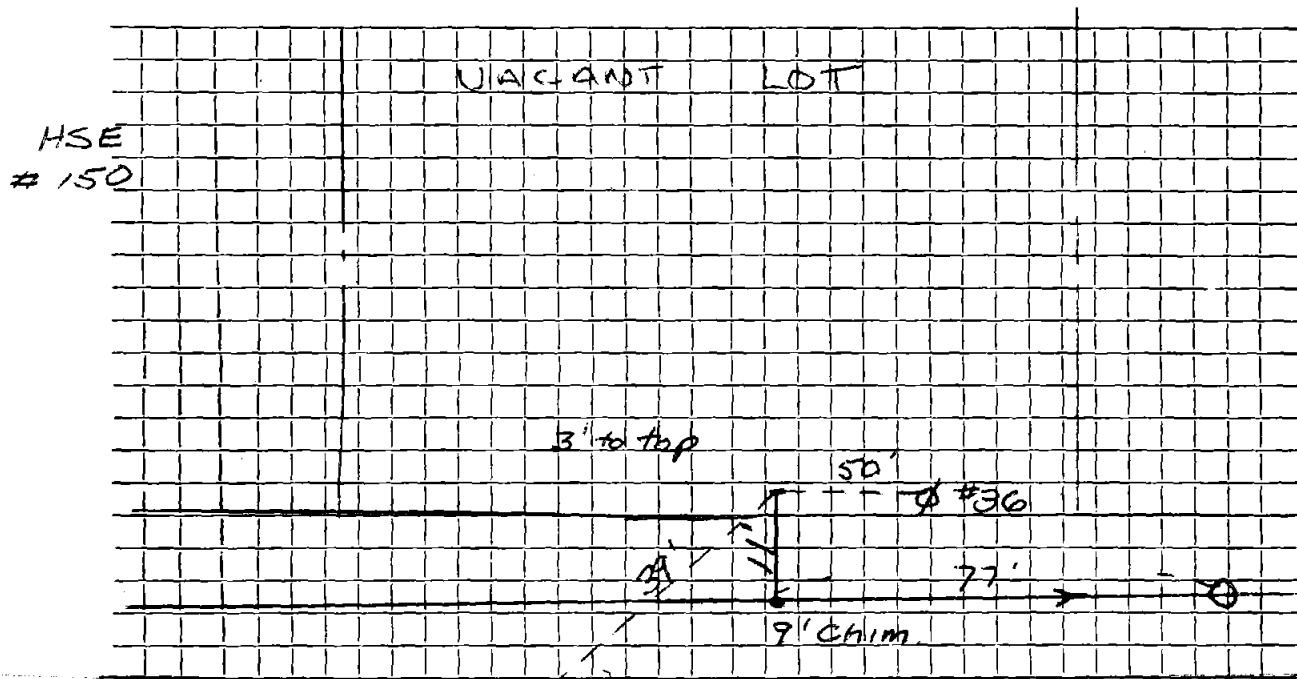

Connection made in CONCORD AVE. 21/37 φ Street.

Work completed

Remarks:

.....

.....