


DATE _____

TOWN OF LEXINGTON — BOARD OF PUBLIC WORKS
SEWER DIVISION

Sketch of Service Here

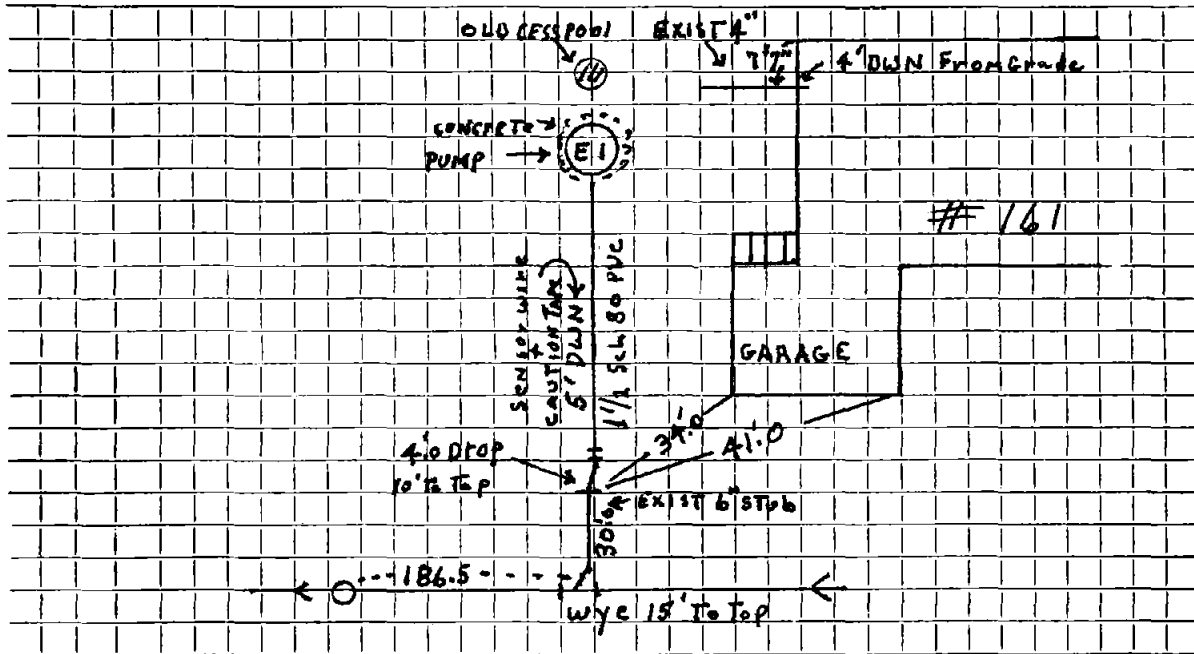

Connection made in CONCORD AVE Street.

Work completed 9/18/02 DAVE SANTO

Remarks: 30 YDS ledge INSP. D.F. ENG.