

Name

Service No.

Address

(162) House # 14 Chadbourne Rd

1577 Central Ave

Location

Kind of Pipe

AC

Size

6"

Size of Main

8"

Repair—Renewal—New Service

Location

Date

Material

Amount

Total

Date

Amount

~~JUNE 28 76 15' 6" AC @ \$10 150 —~~


6-28-76

15' 6" A.C.

DATE JUNE 28, 1976

TOWN OF LEXINGTON — BOARD OF PUBLIC WORKS
SEWER DIVISION

Sketch of Service Here

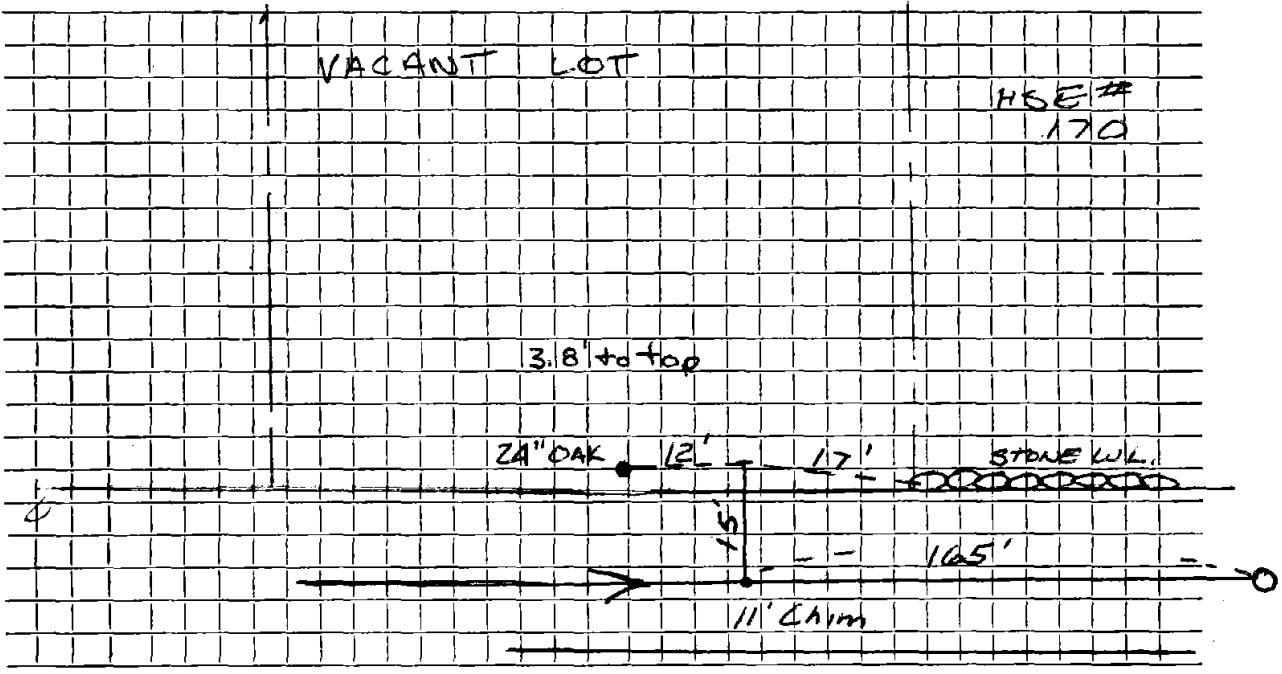

Connection made in CONCORD AVE Street. Work completed

Remarks:

.....

.....