




DATE July 7, 1976

TOWN OF LEXINGTON — BOARD OF PUBLIC WORKS  
SEWER DIVISION

Sketch of Service Here

**169**

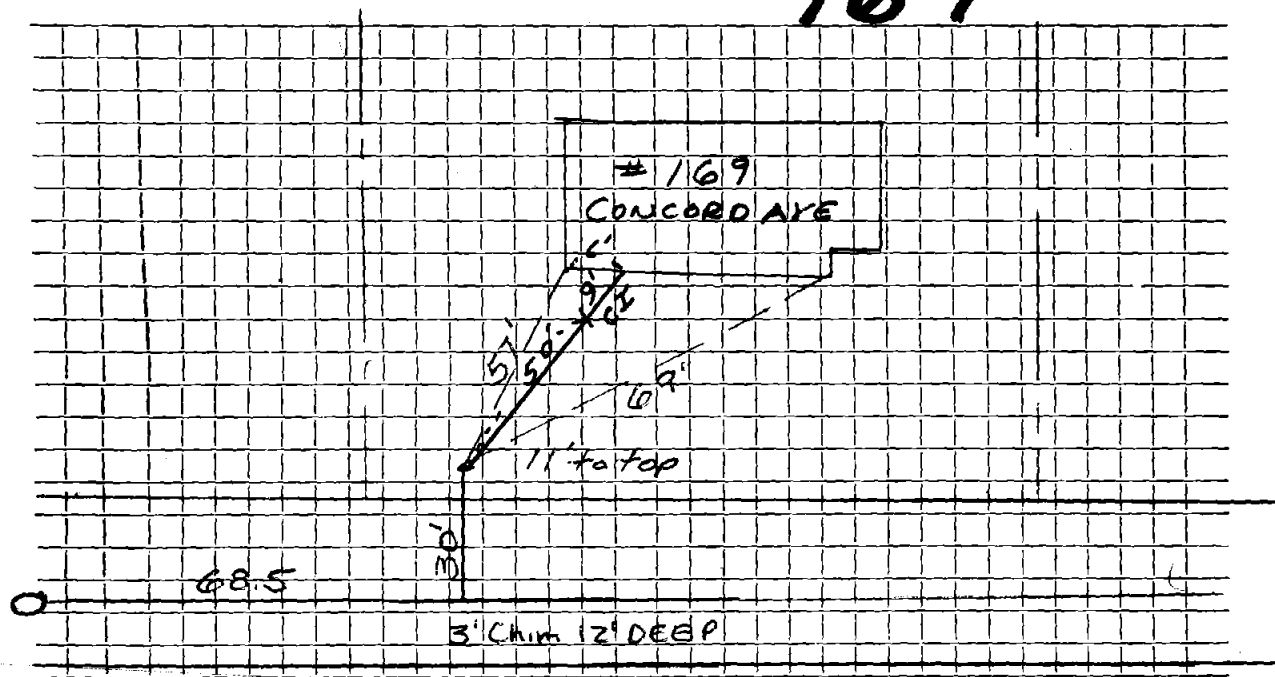

Connection made in CONCORD AVE Street. Work completed .....

Remarks: 17 YDS. LEAGE .....