


DATE JUNE 25, 1976

TOWN OF LEXINGTON — BOARD OF PUBLIC WORKS
SEWER DIVISION

Sketch of Service Here

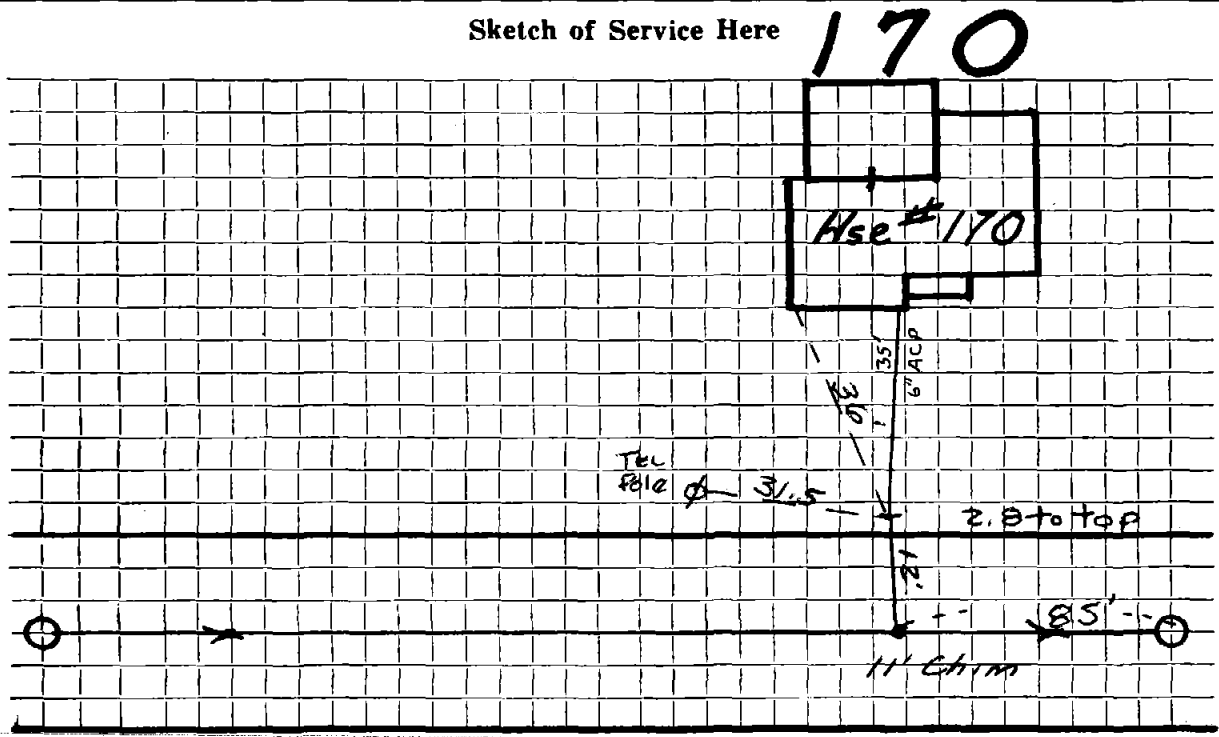

Connection made in CONCORD AVE Street. Work completed

Remarks:

.....

.....