


DATE _____

TOWN OF LEXINGTON — BOARD OF PUBLIC WORKS
SEWER DIVISION

Sketch of Service Here **177**

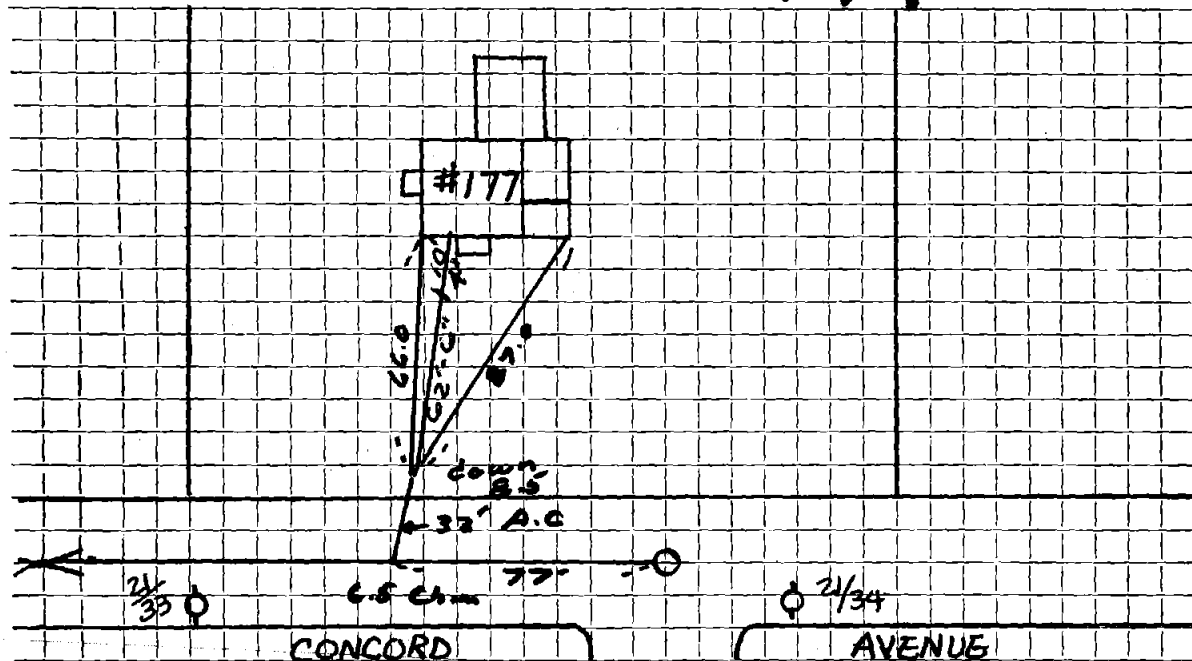

Connection made in G.O.H. CORP. AVE. Street. Work completed

Remarks:
.....
.....