

Name

Service No.

Address

#178



Concord Avenue

Location

Kind of Pipe

Size

Size of Main

Repair—Renewal—New Service

Location

Date

Material

Amount

Total

Date

Amount

~~11/15/74 17' A.C. @ \$17.00 \$119.00~~

11-13-74

17' 6" A.C.




DATE _____

TOWN OF LEXINGTON — BOARD OF PUBLIC WORKS

SEWER DIVISION

Sketch of Service Here **178**

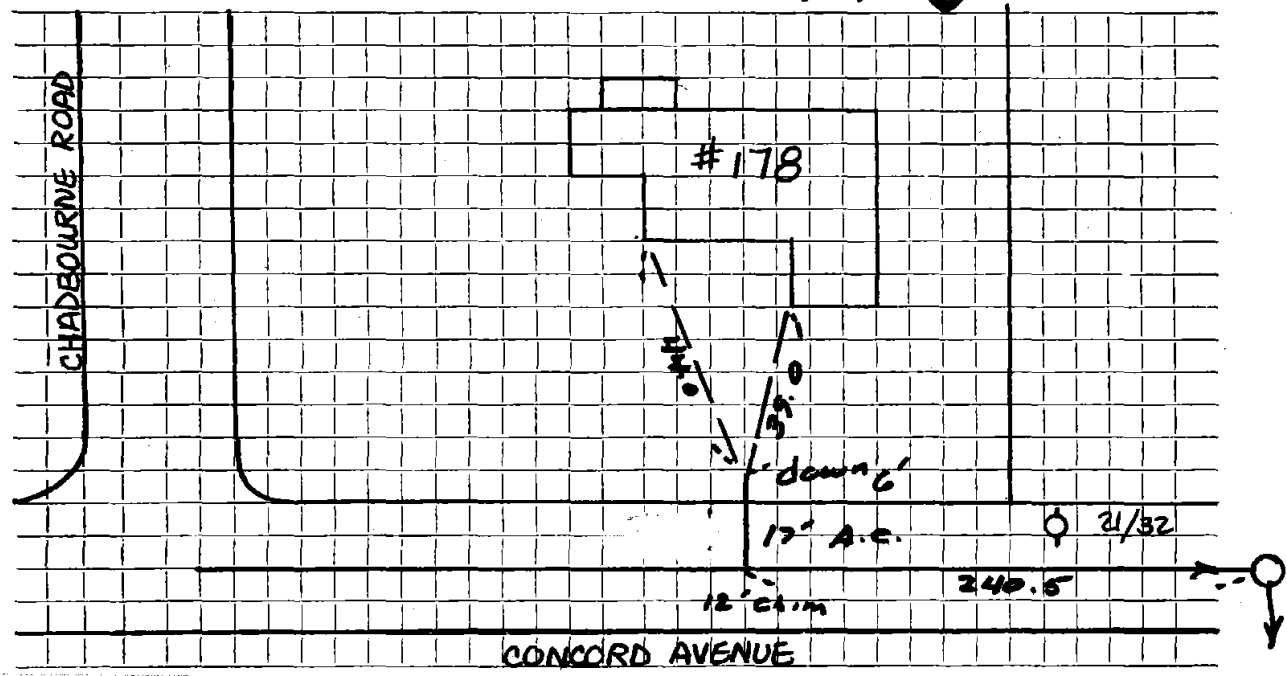

Connection made in Street. Work completed

Remarks:
.....
.....